




街区面積 6329.29  
 画地面積 6329.23  
 差 0.06

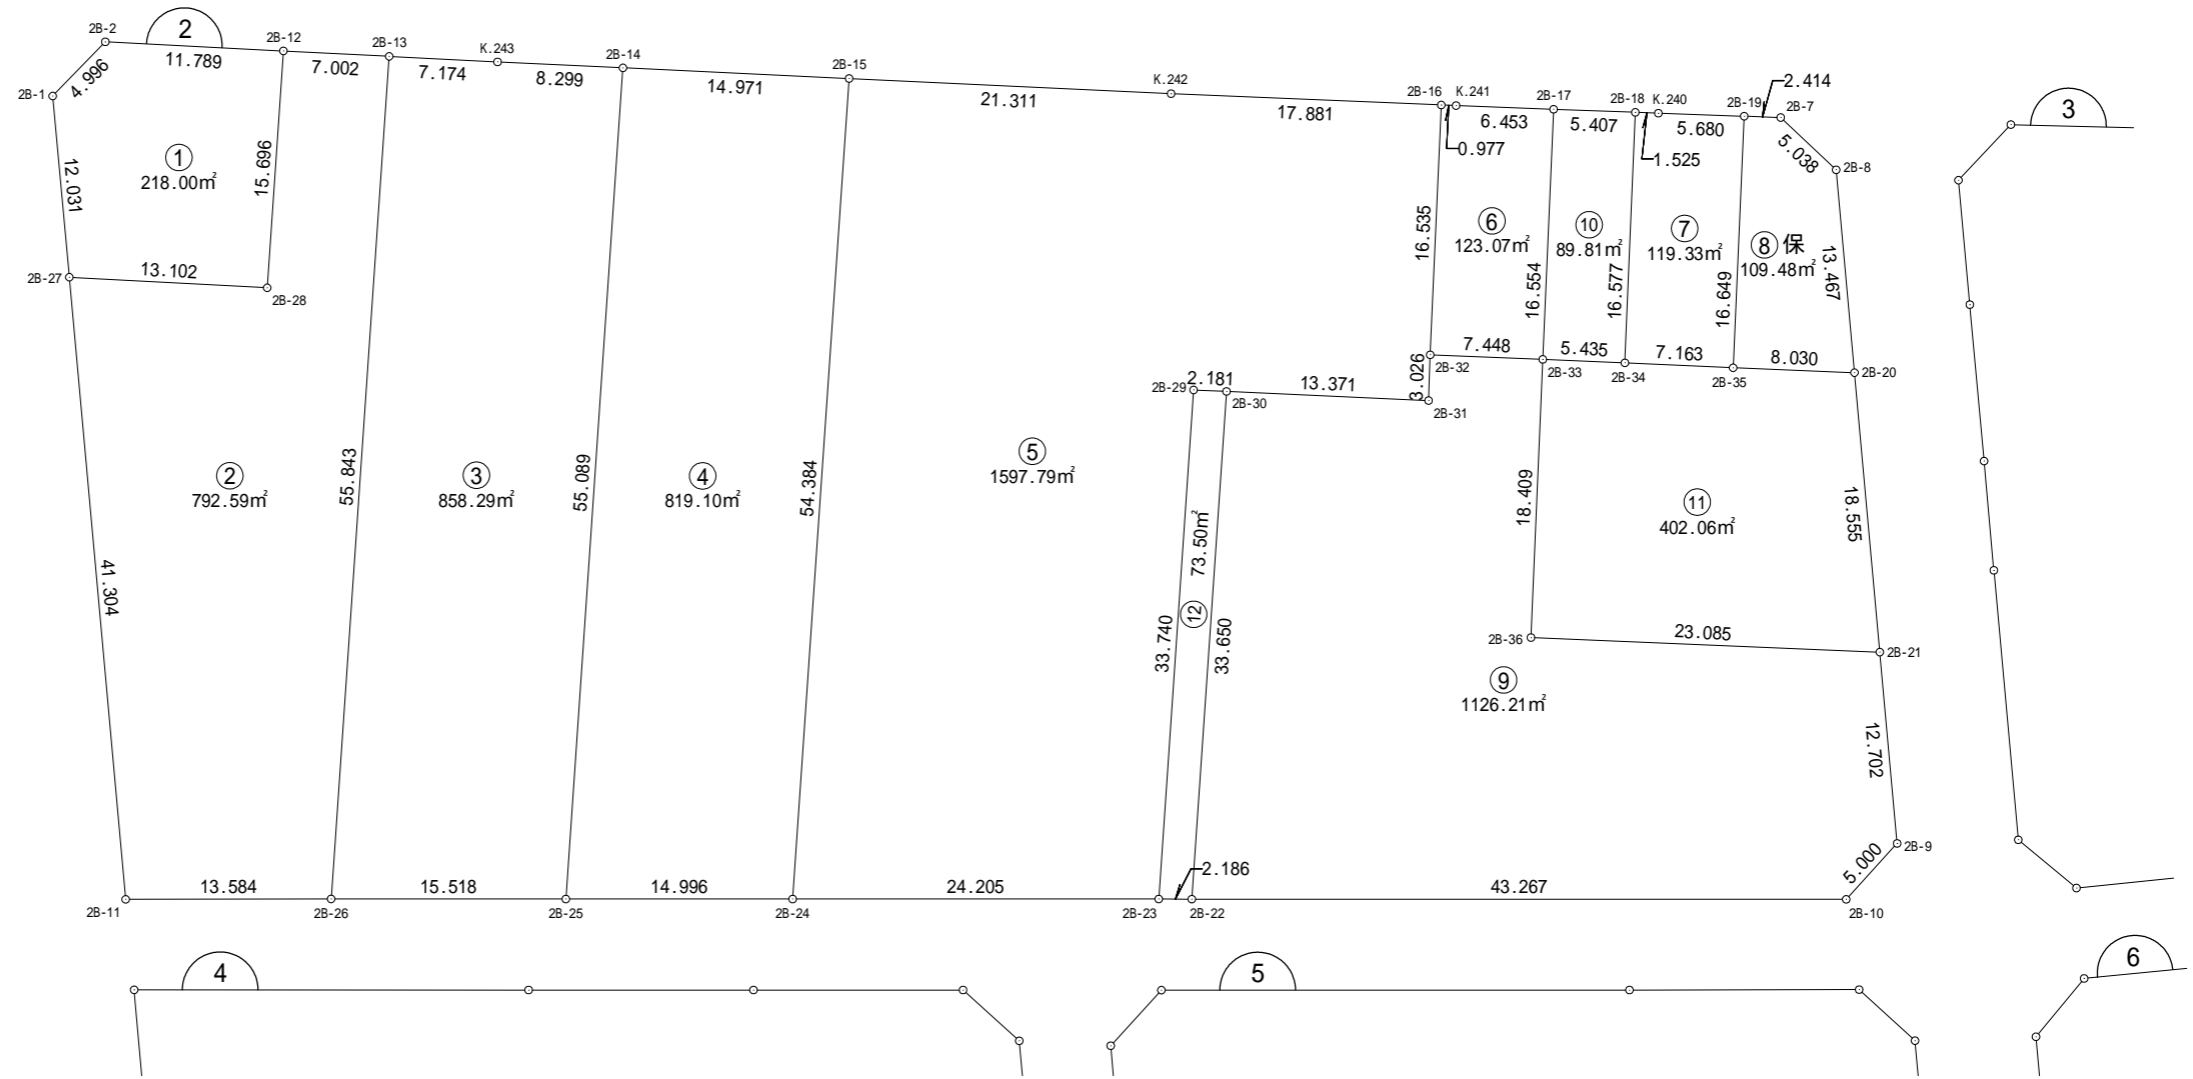

出来形確認測量図


街区番号 4BL

街区面積 10152.05  
 画地面積 10151.95  
 差 0.10

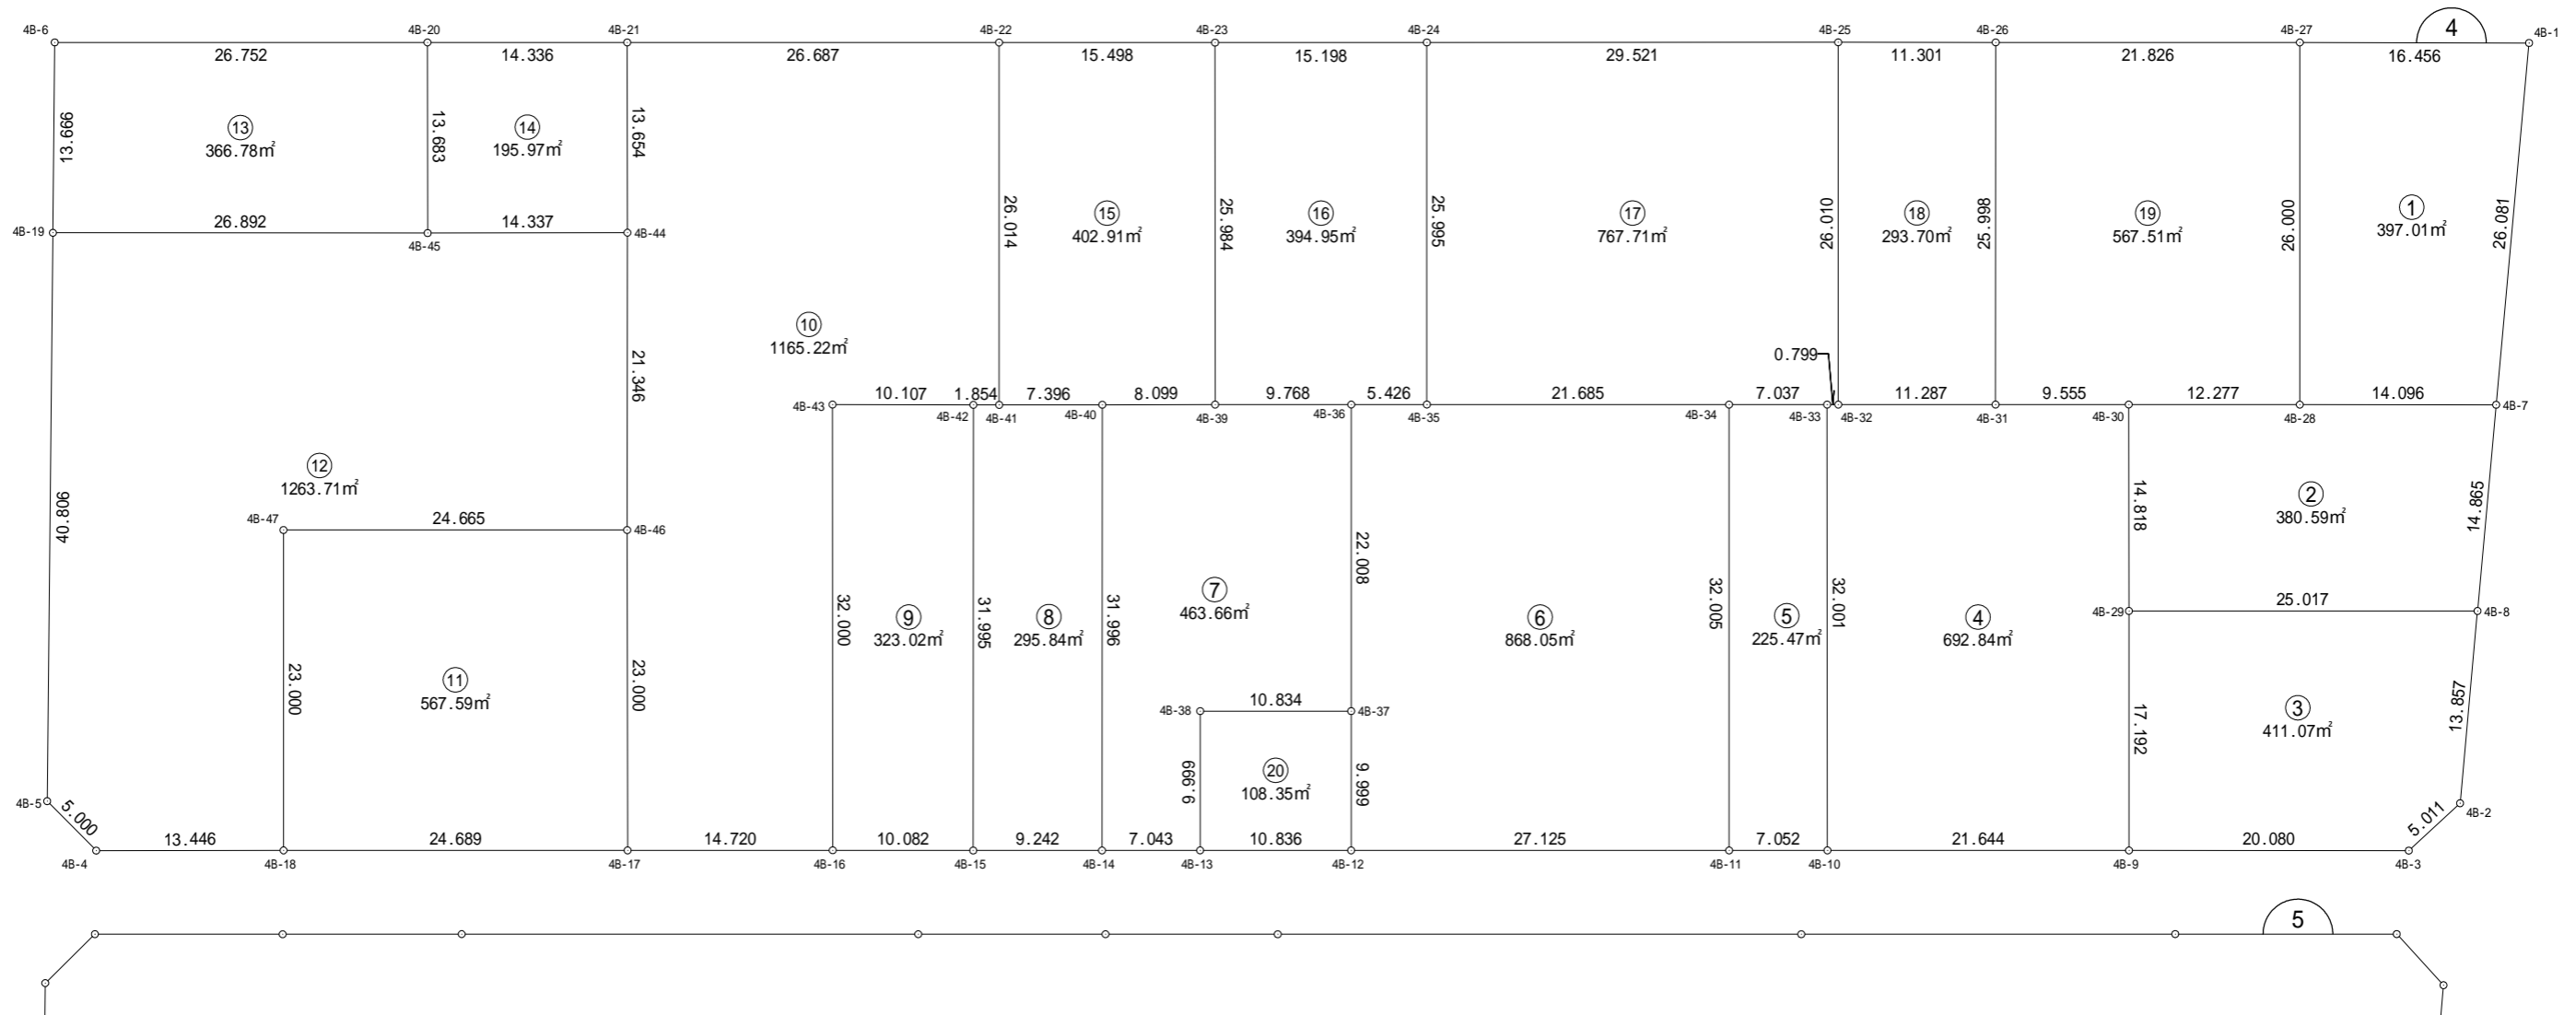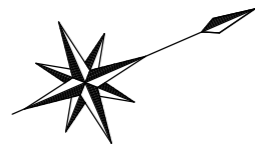

縮尺 1 : 500



街区面積 8992.81  
 画地面積 8992.66  
 差 0.15

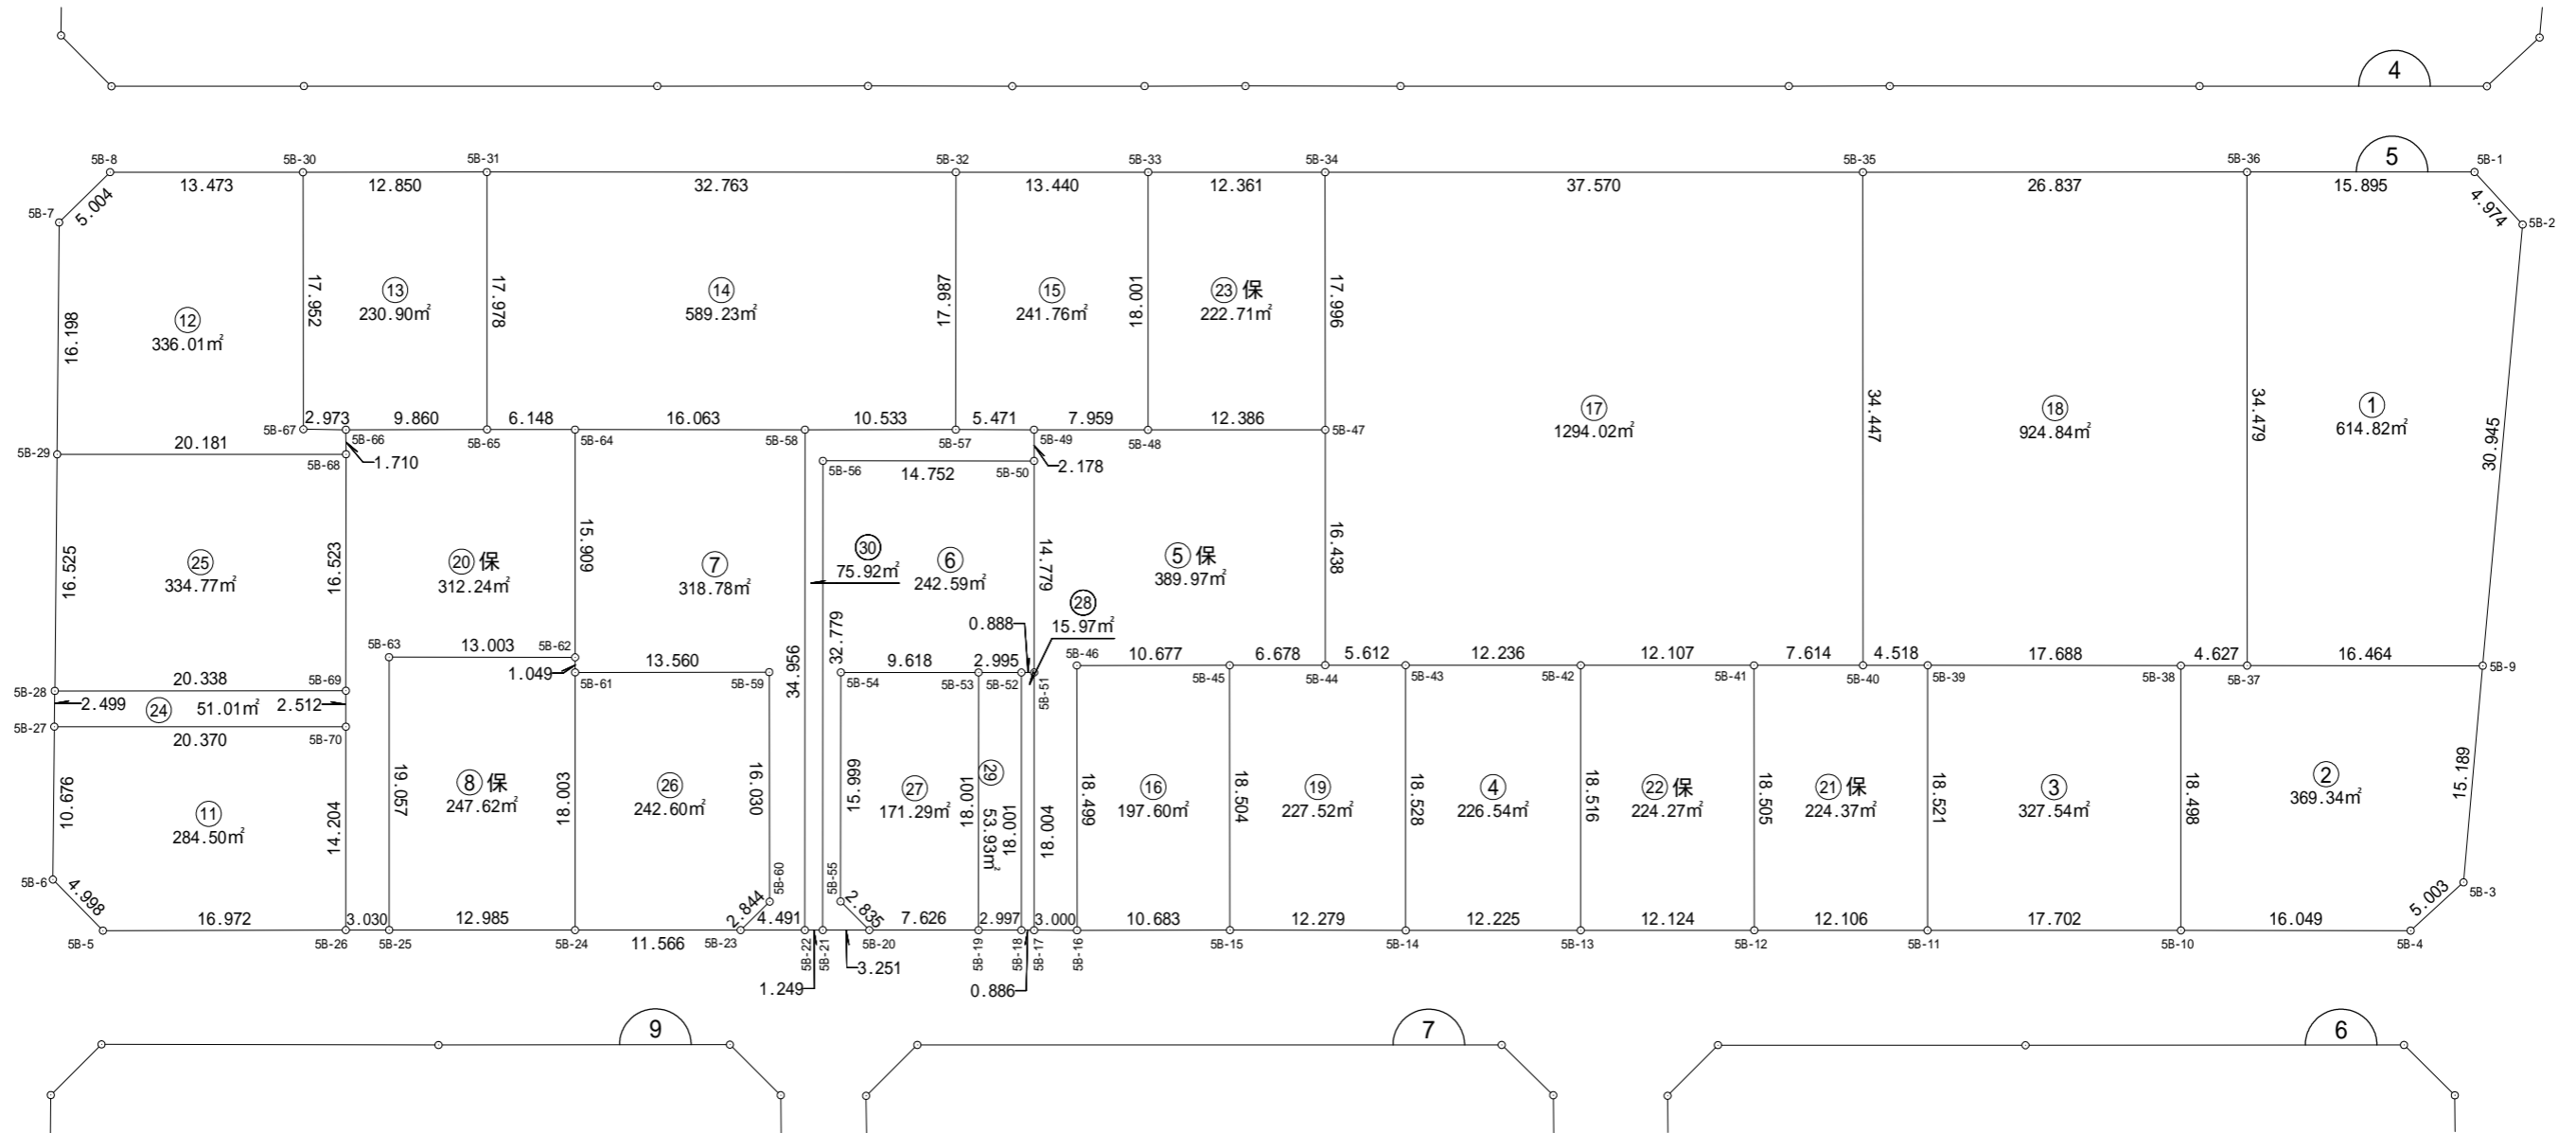



街区面積 5832.98

画地面積 5832.83

差 0.15

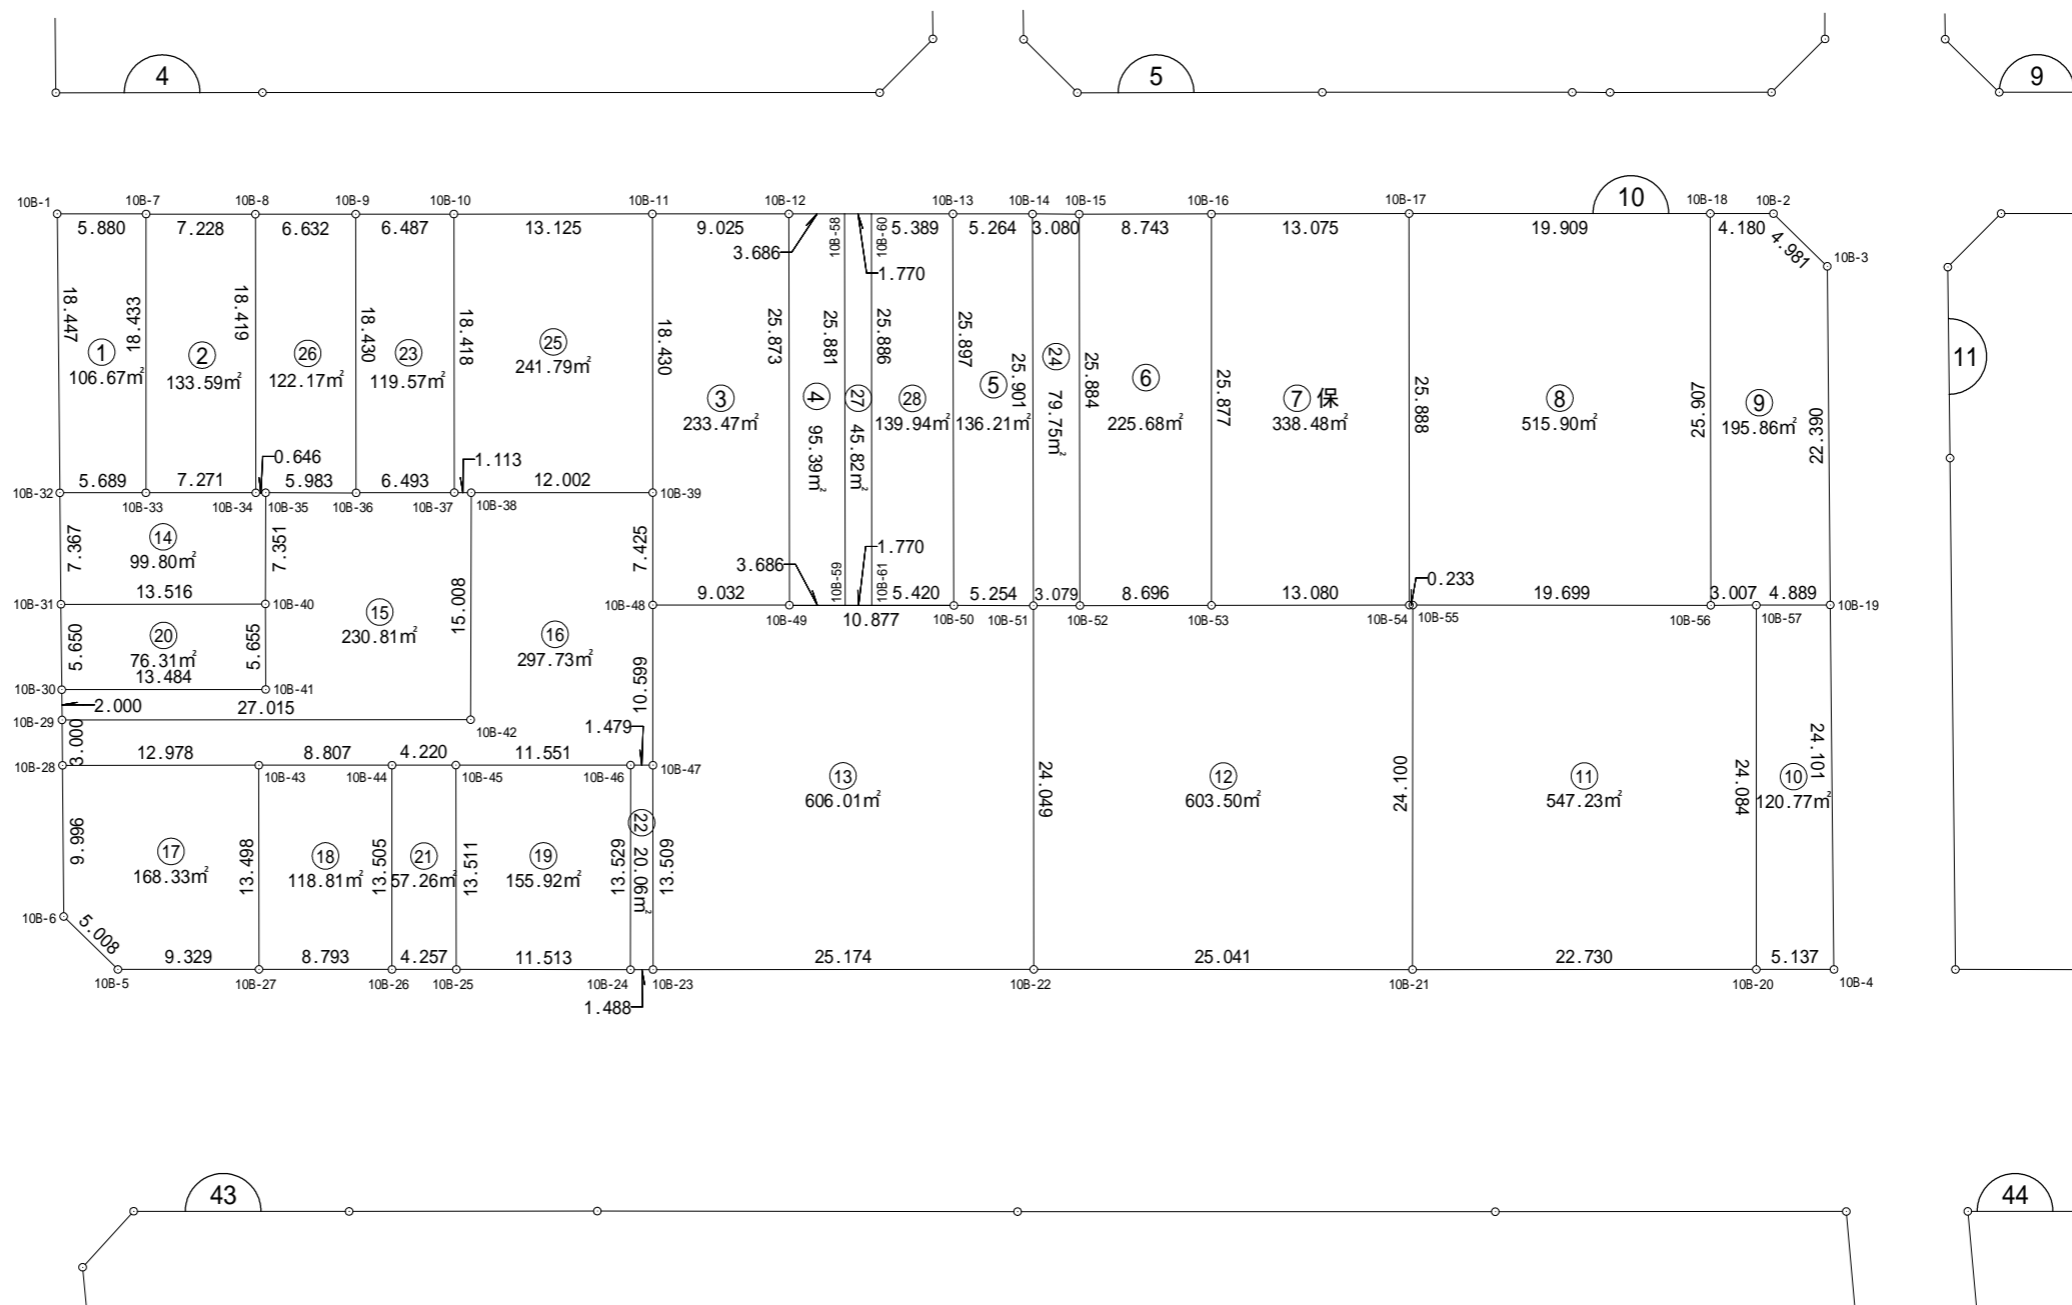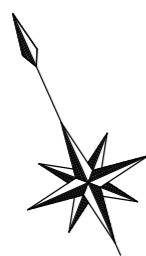

街区面積 4273.31  
 画地面積 4273.26  
 差 0.05

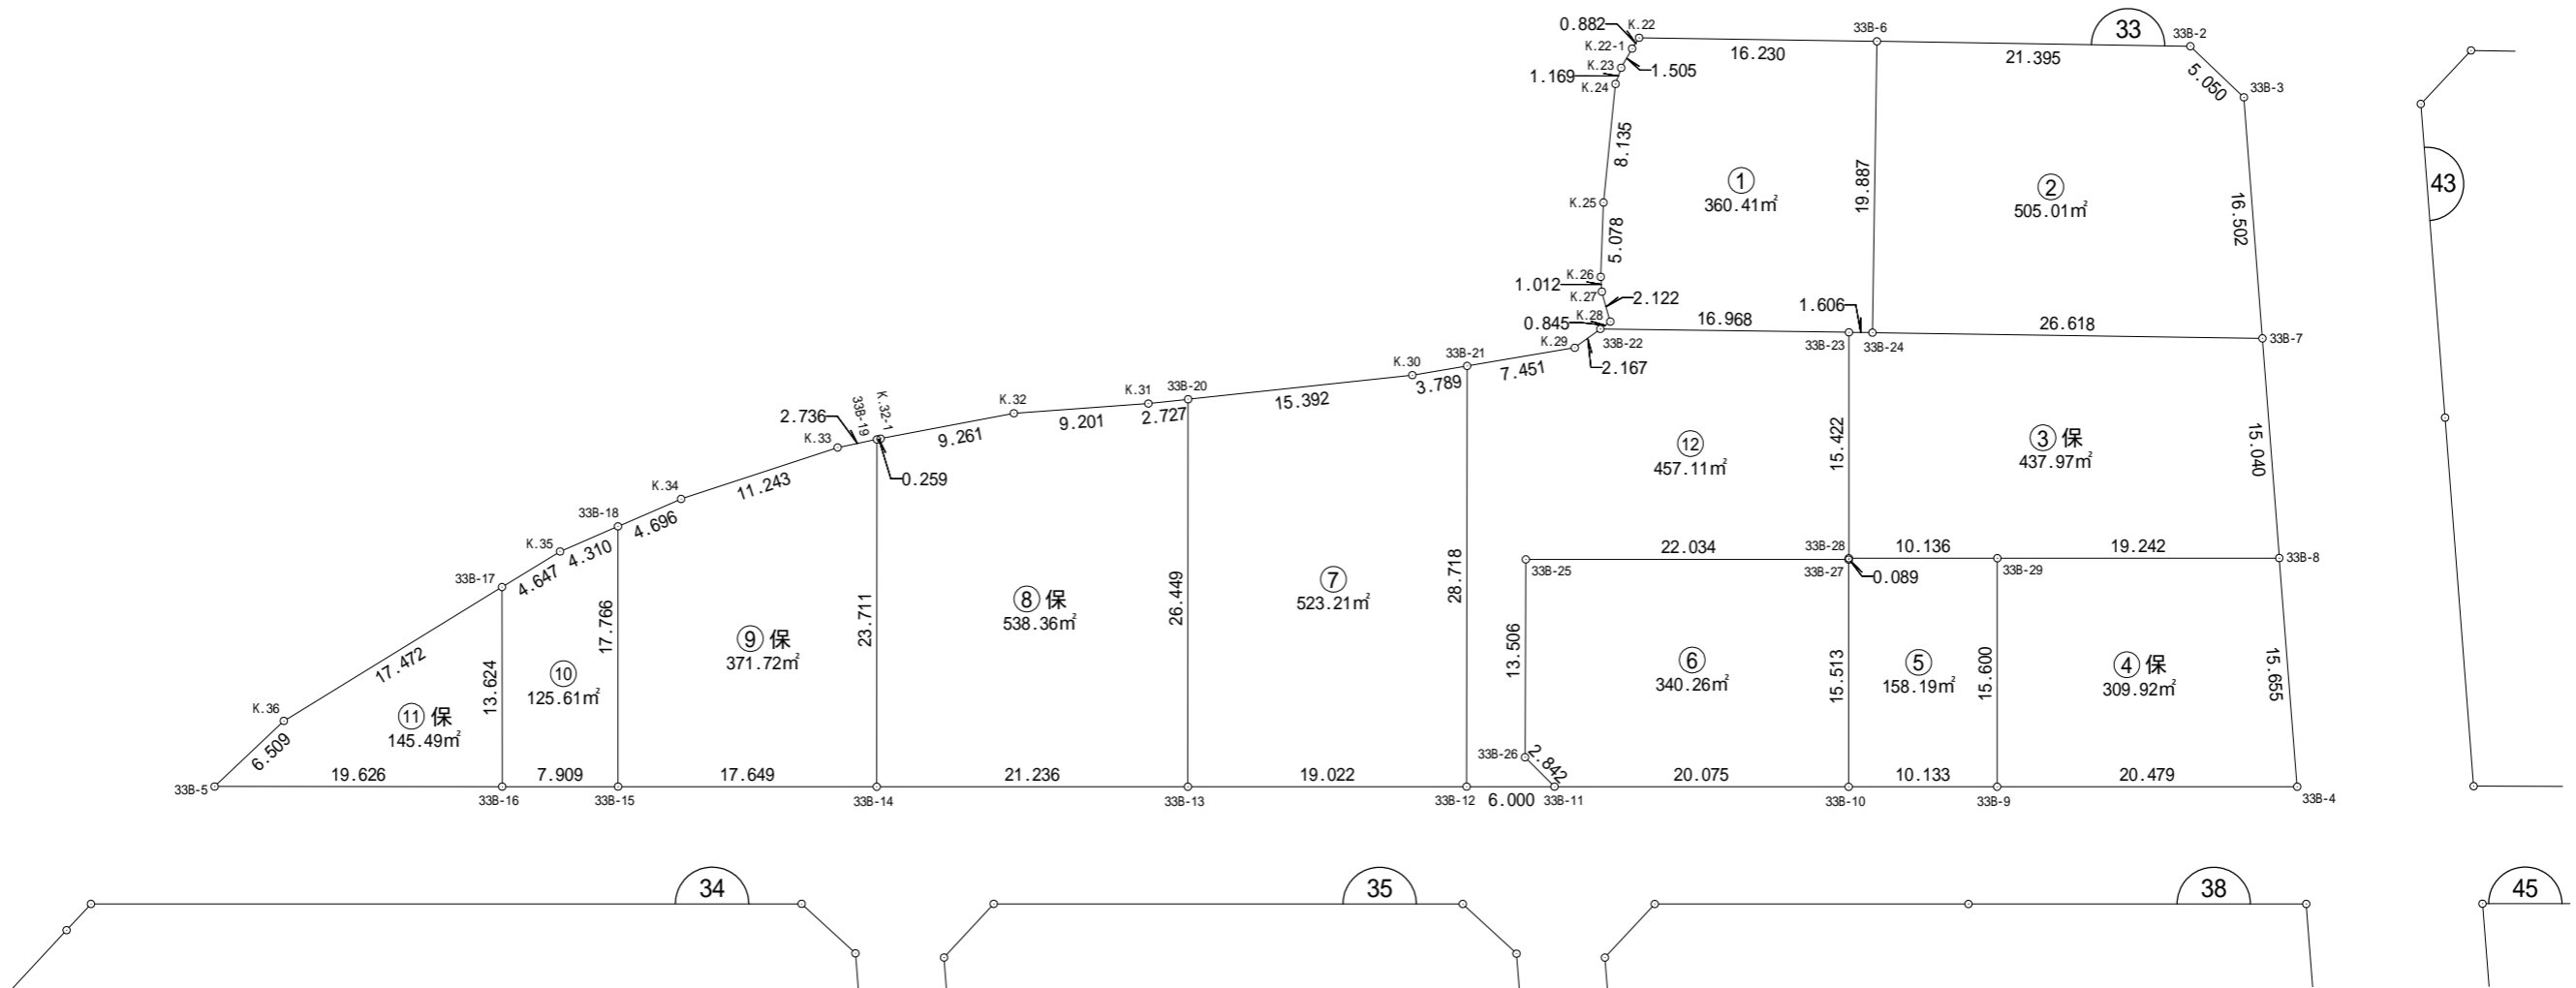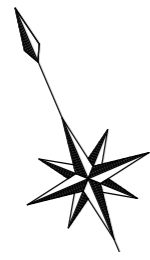





街区面積 2639.99

画地面積 2639.99

0.00

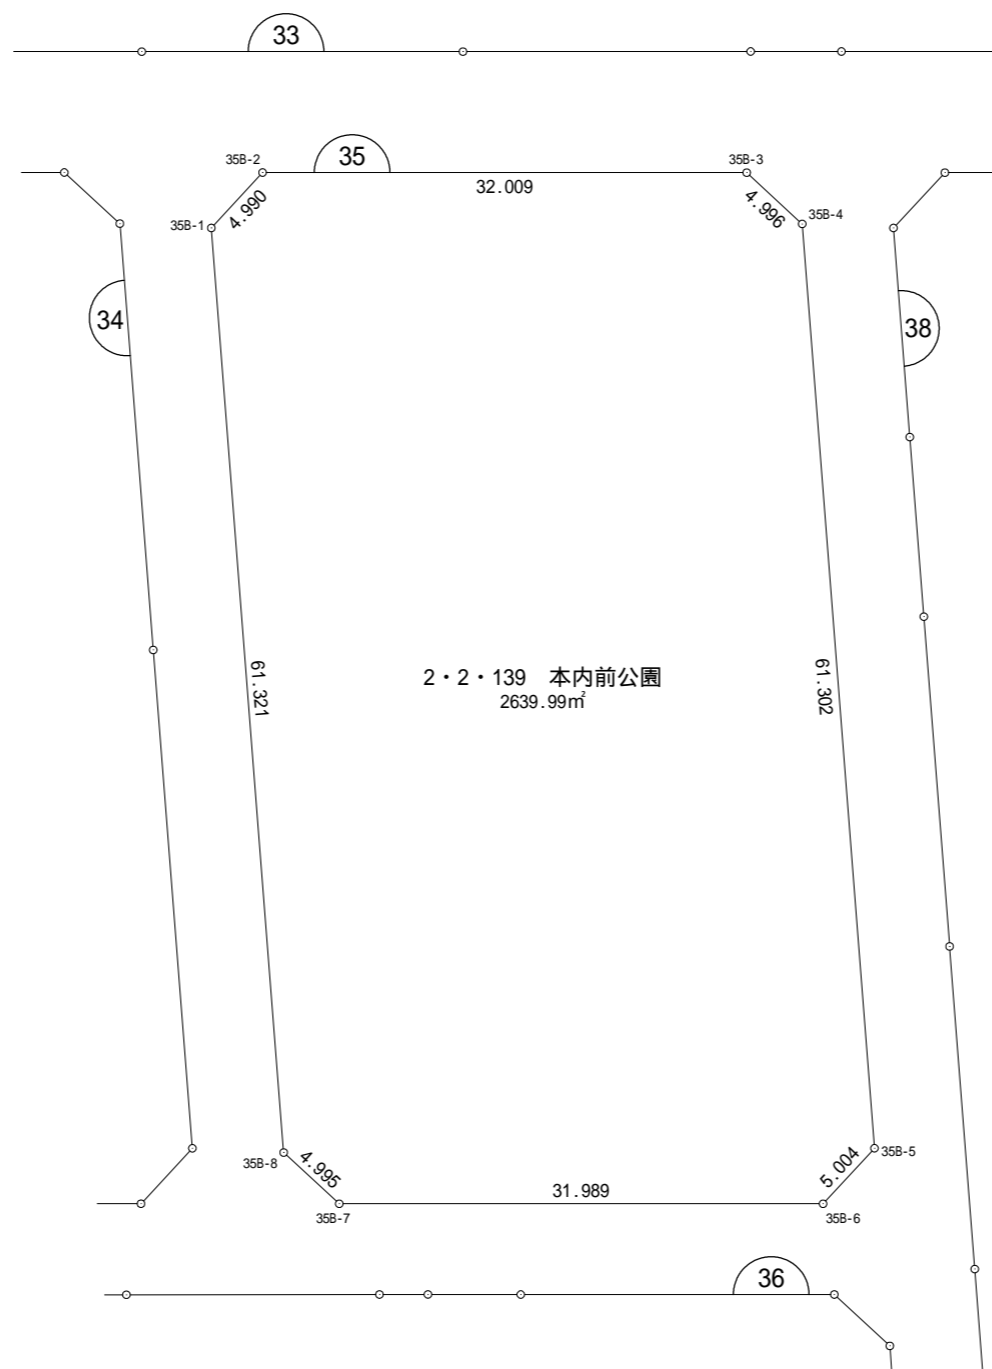

街区面積 8825.31  
 画地面積 8825.22  
 差 0.09

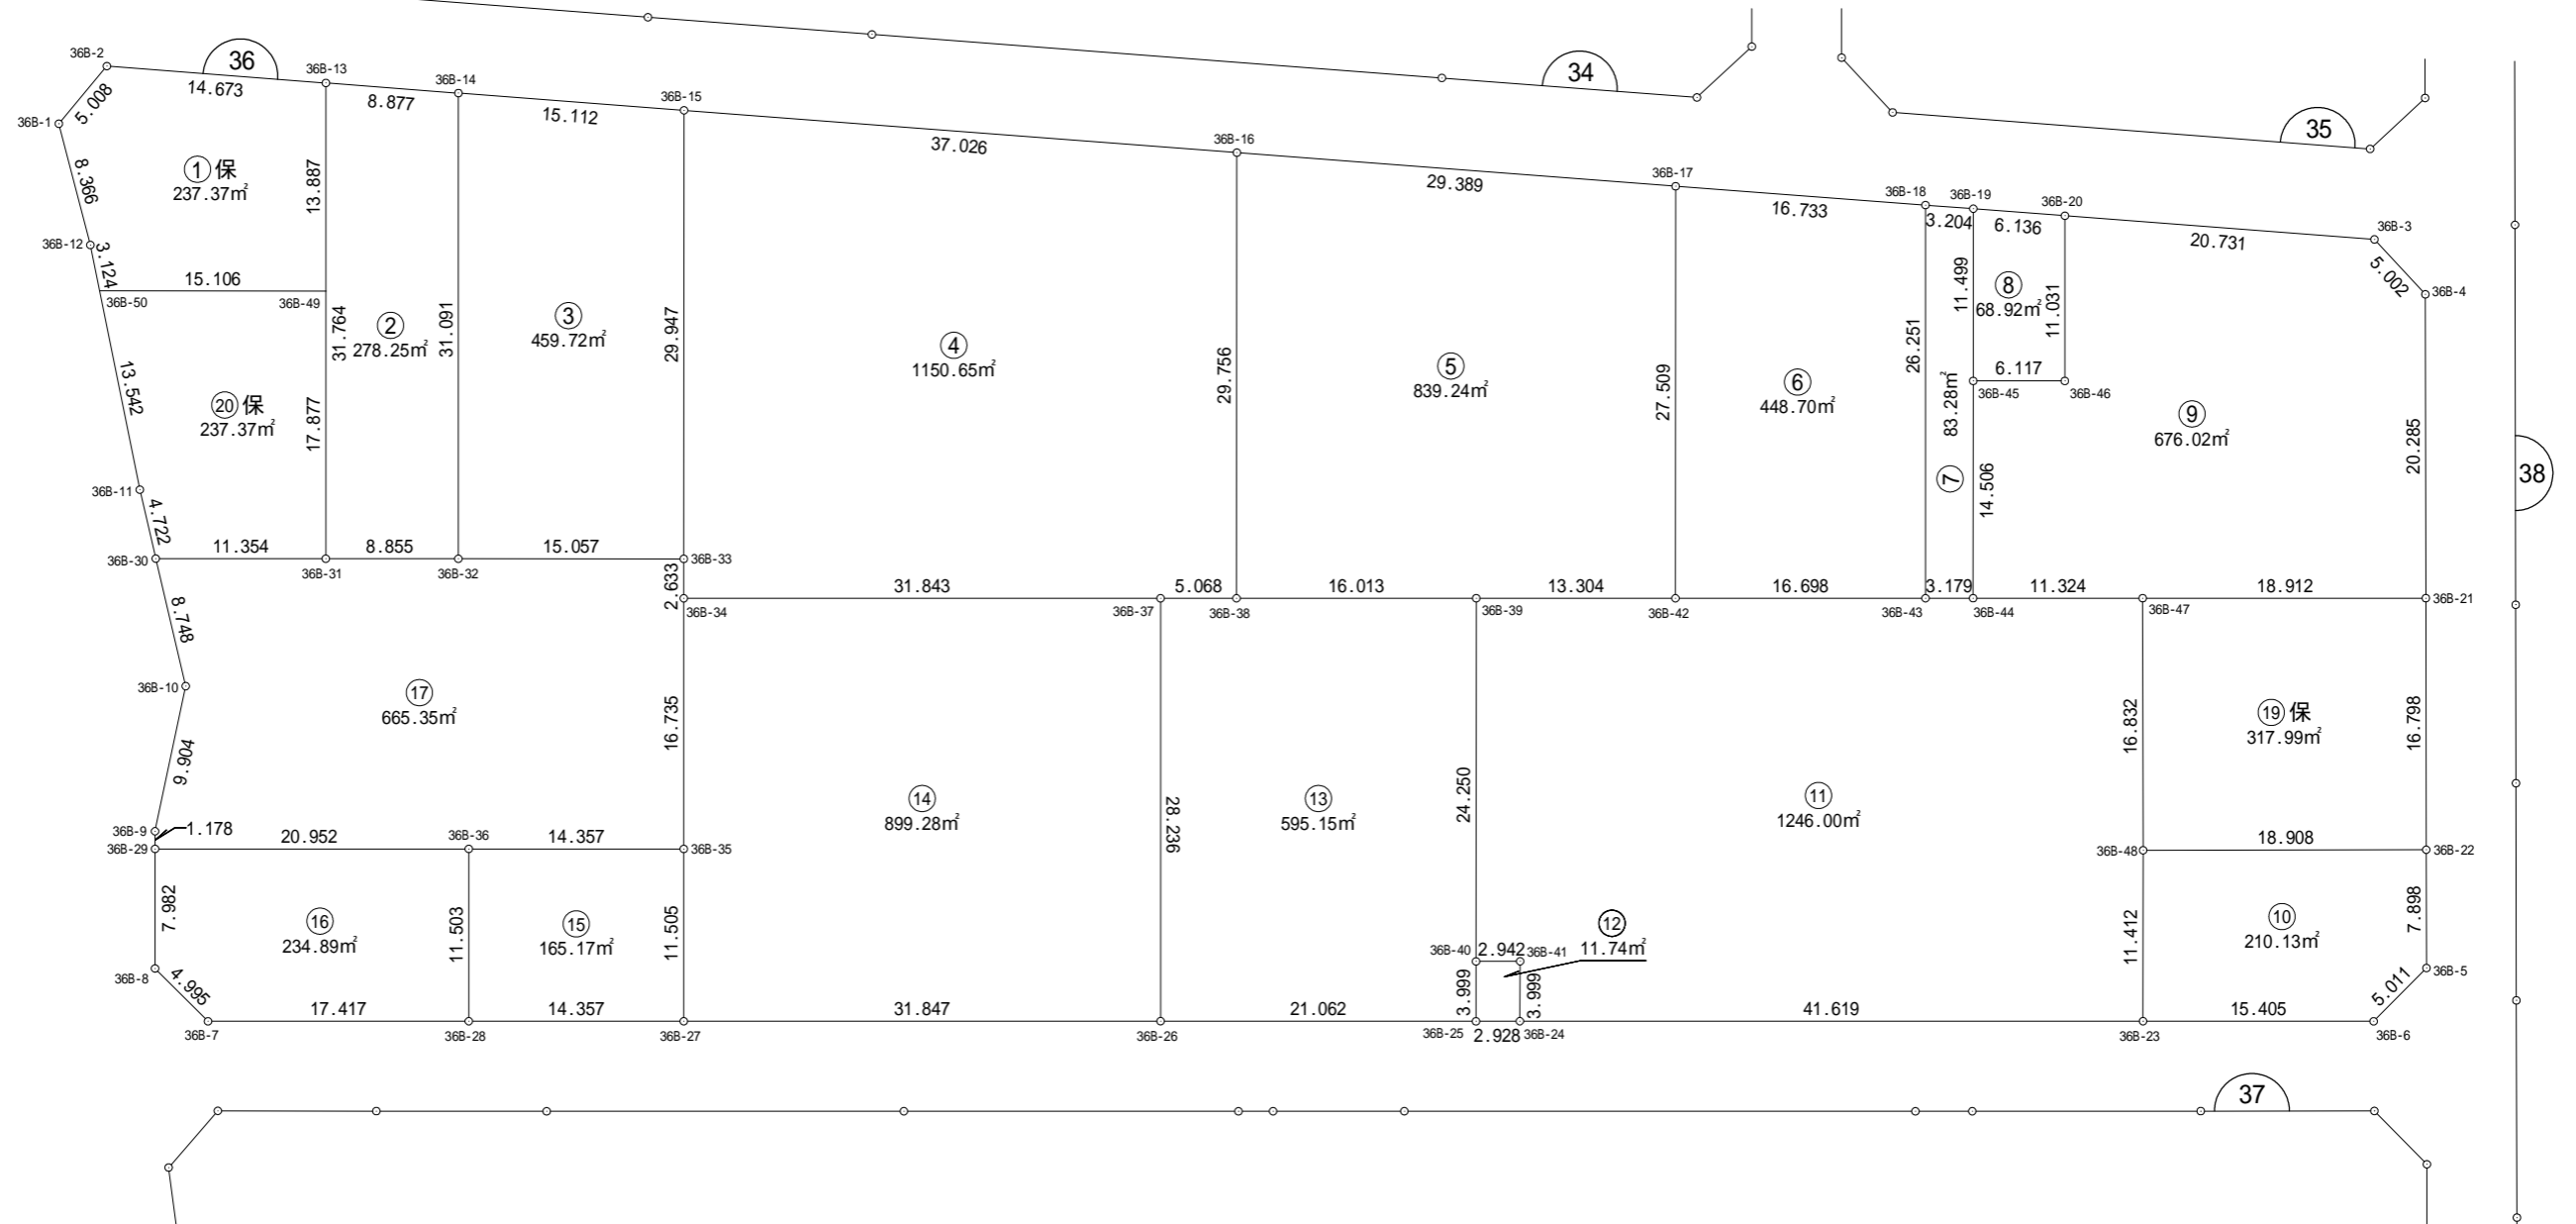







街区面積 5990.38

画地面積 5990.29


差 0.09

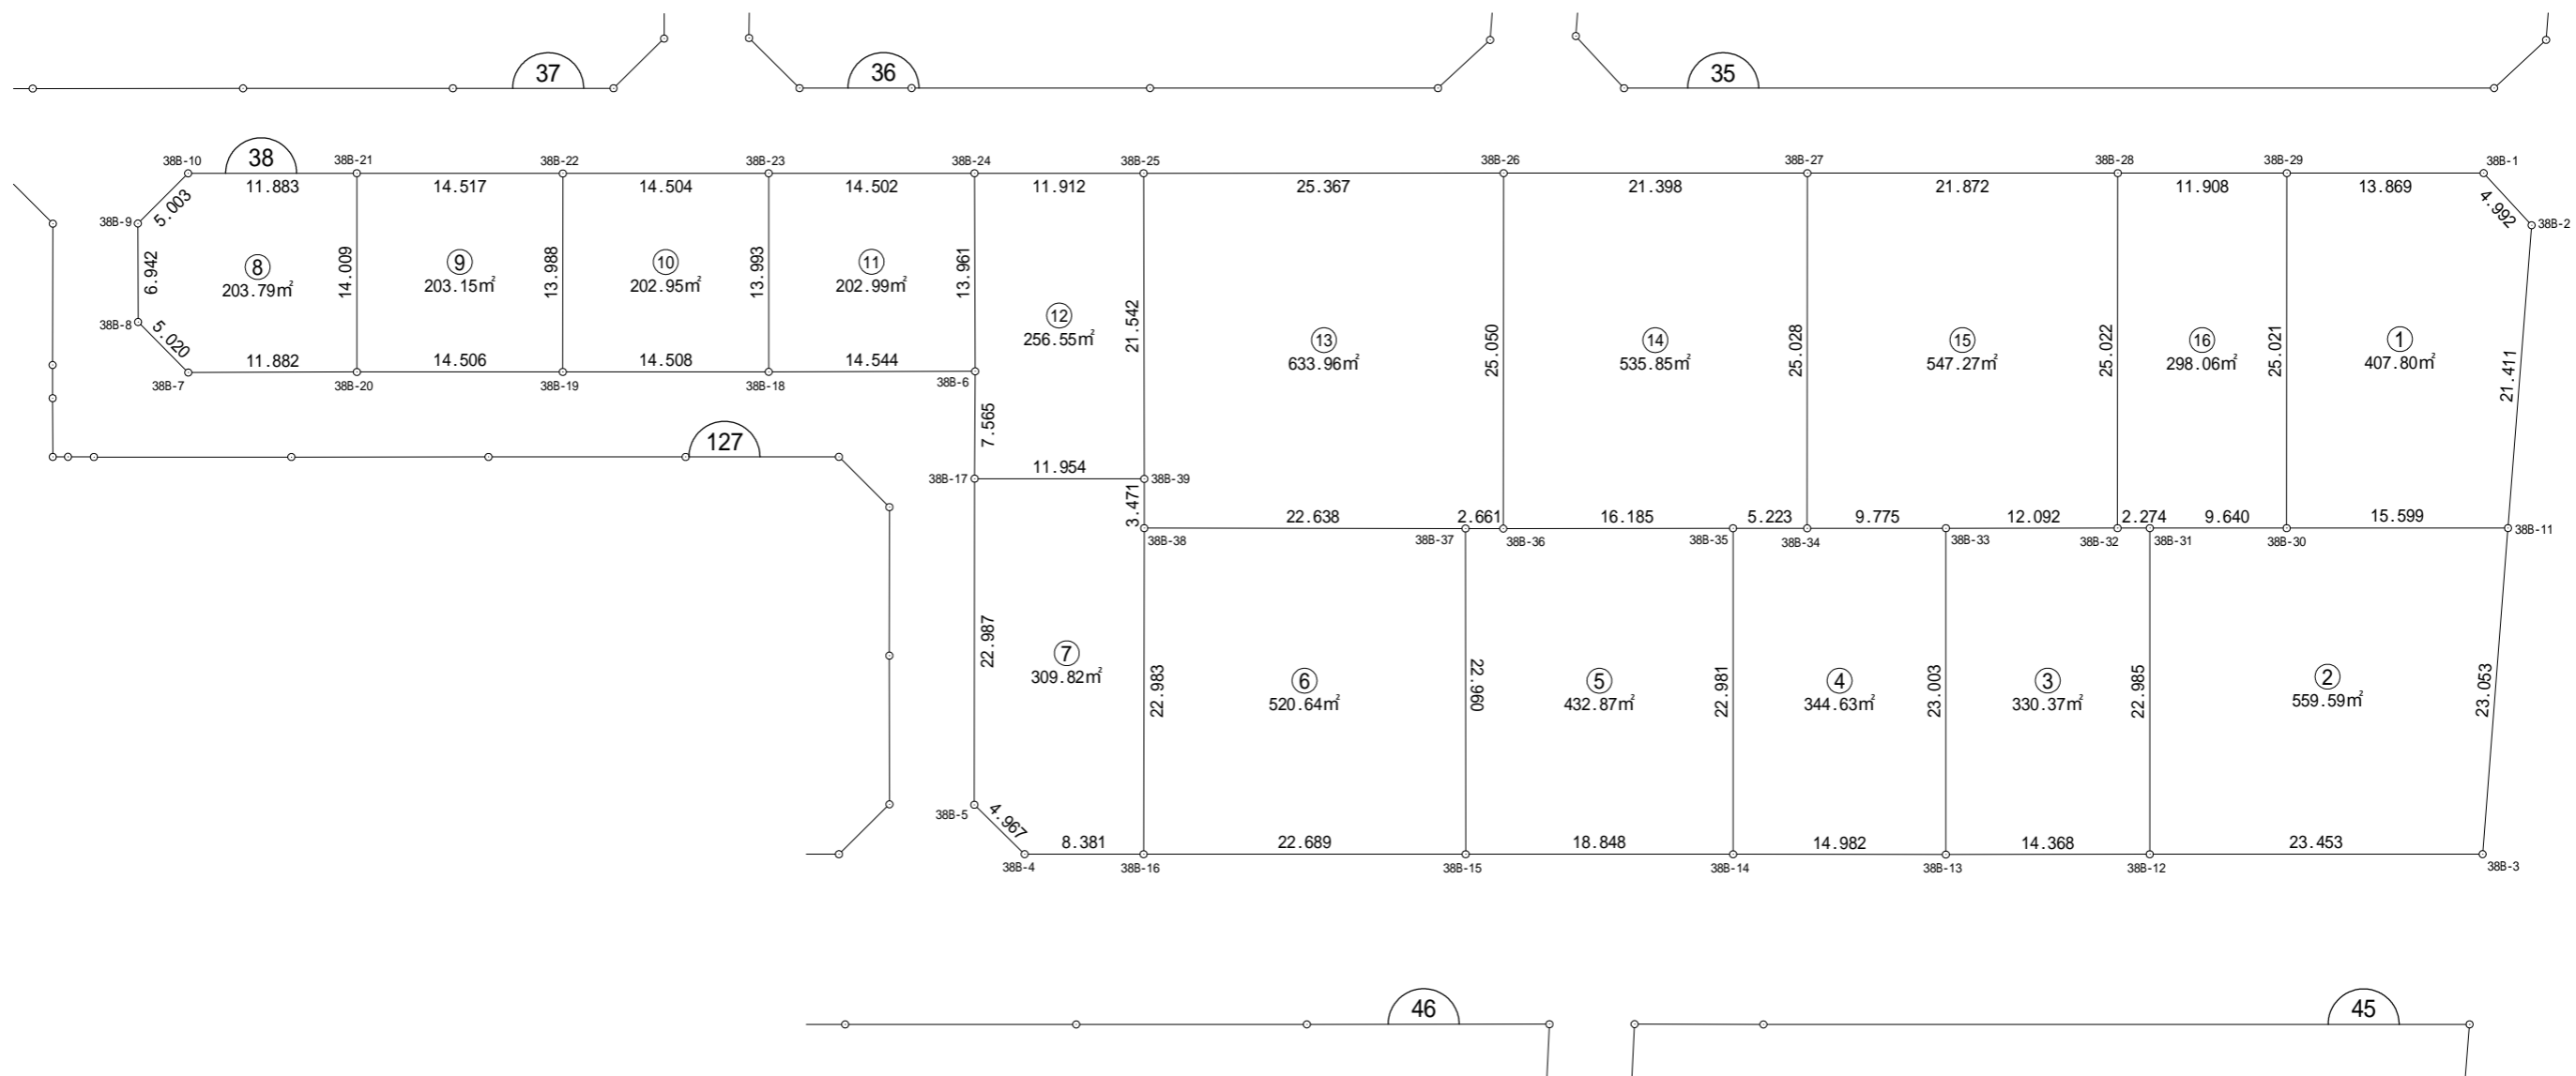

街区面積 6130.47  
 画地面積 6130.42  
 差 0.05

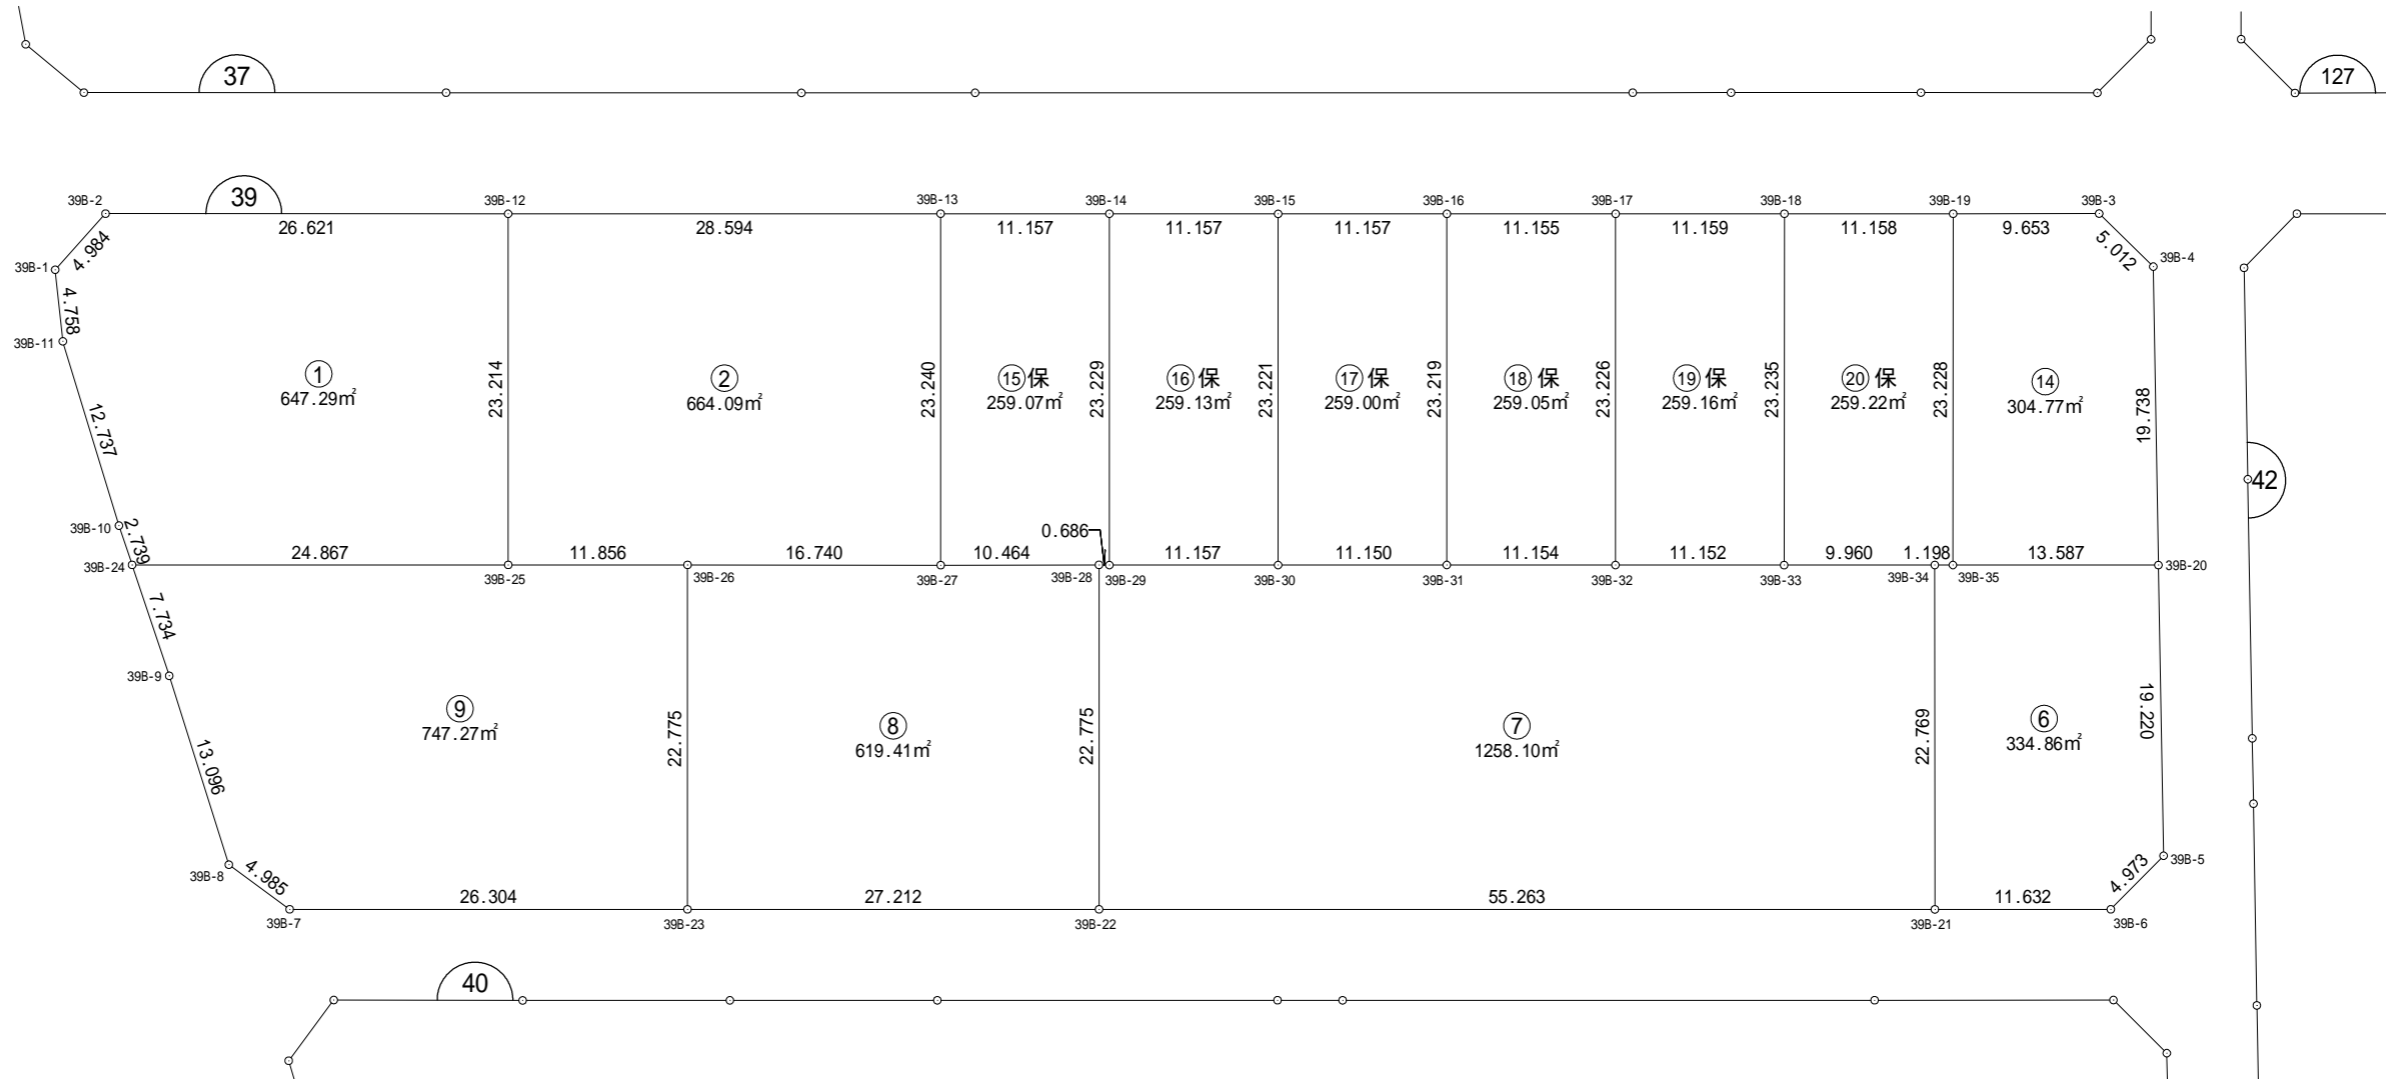

街区面積 5713.00  
 画地面積 5712.95  
 差 0.05

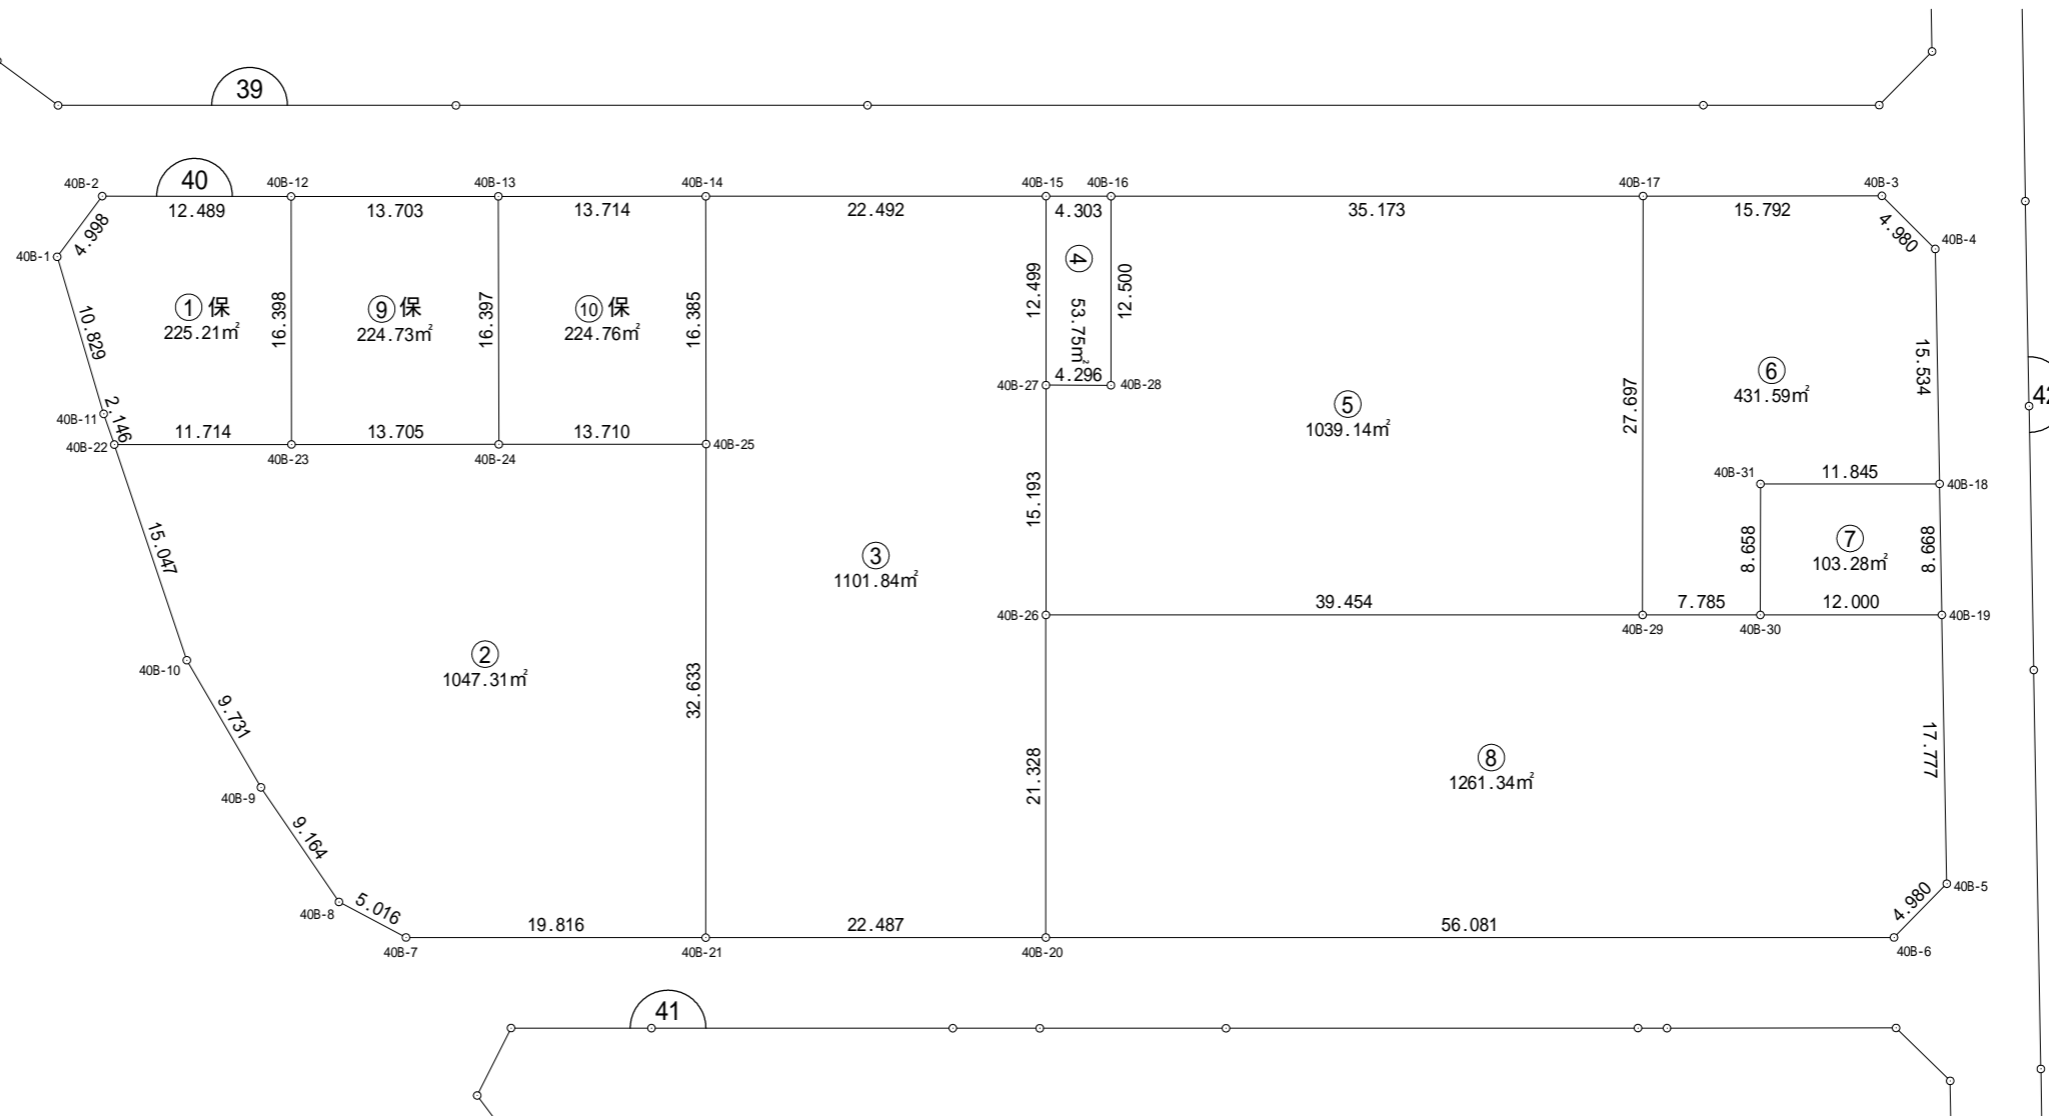







街区面積 5757.75

画地面積 5757.71

差 0.04

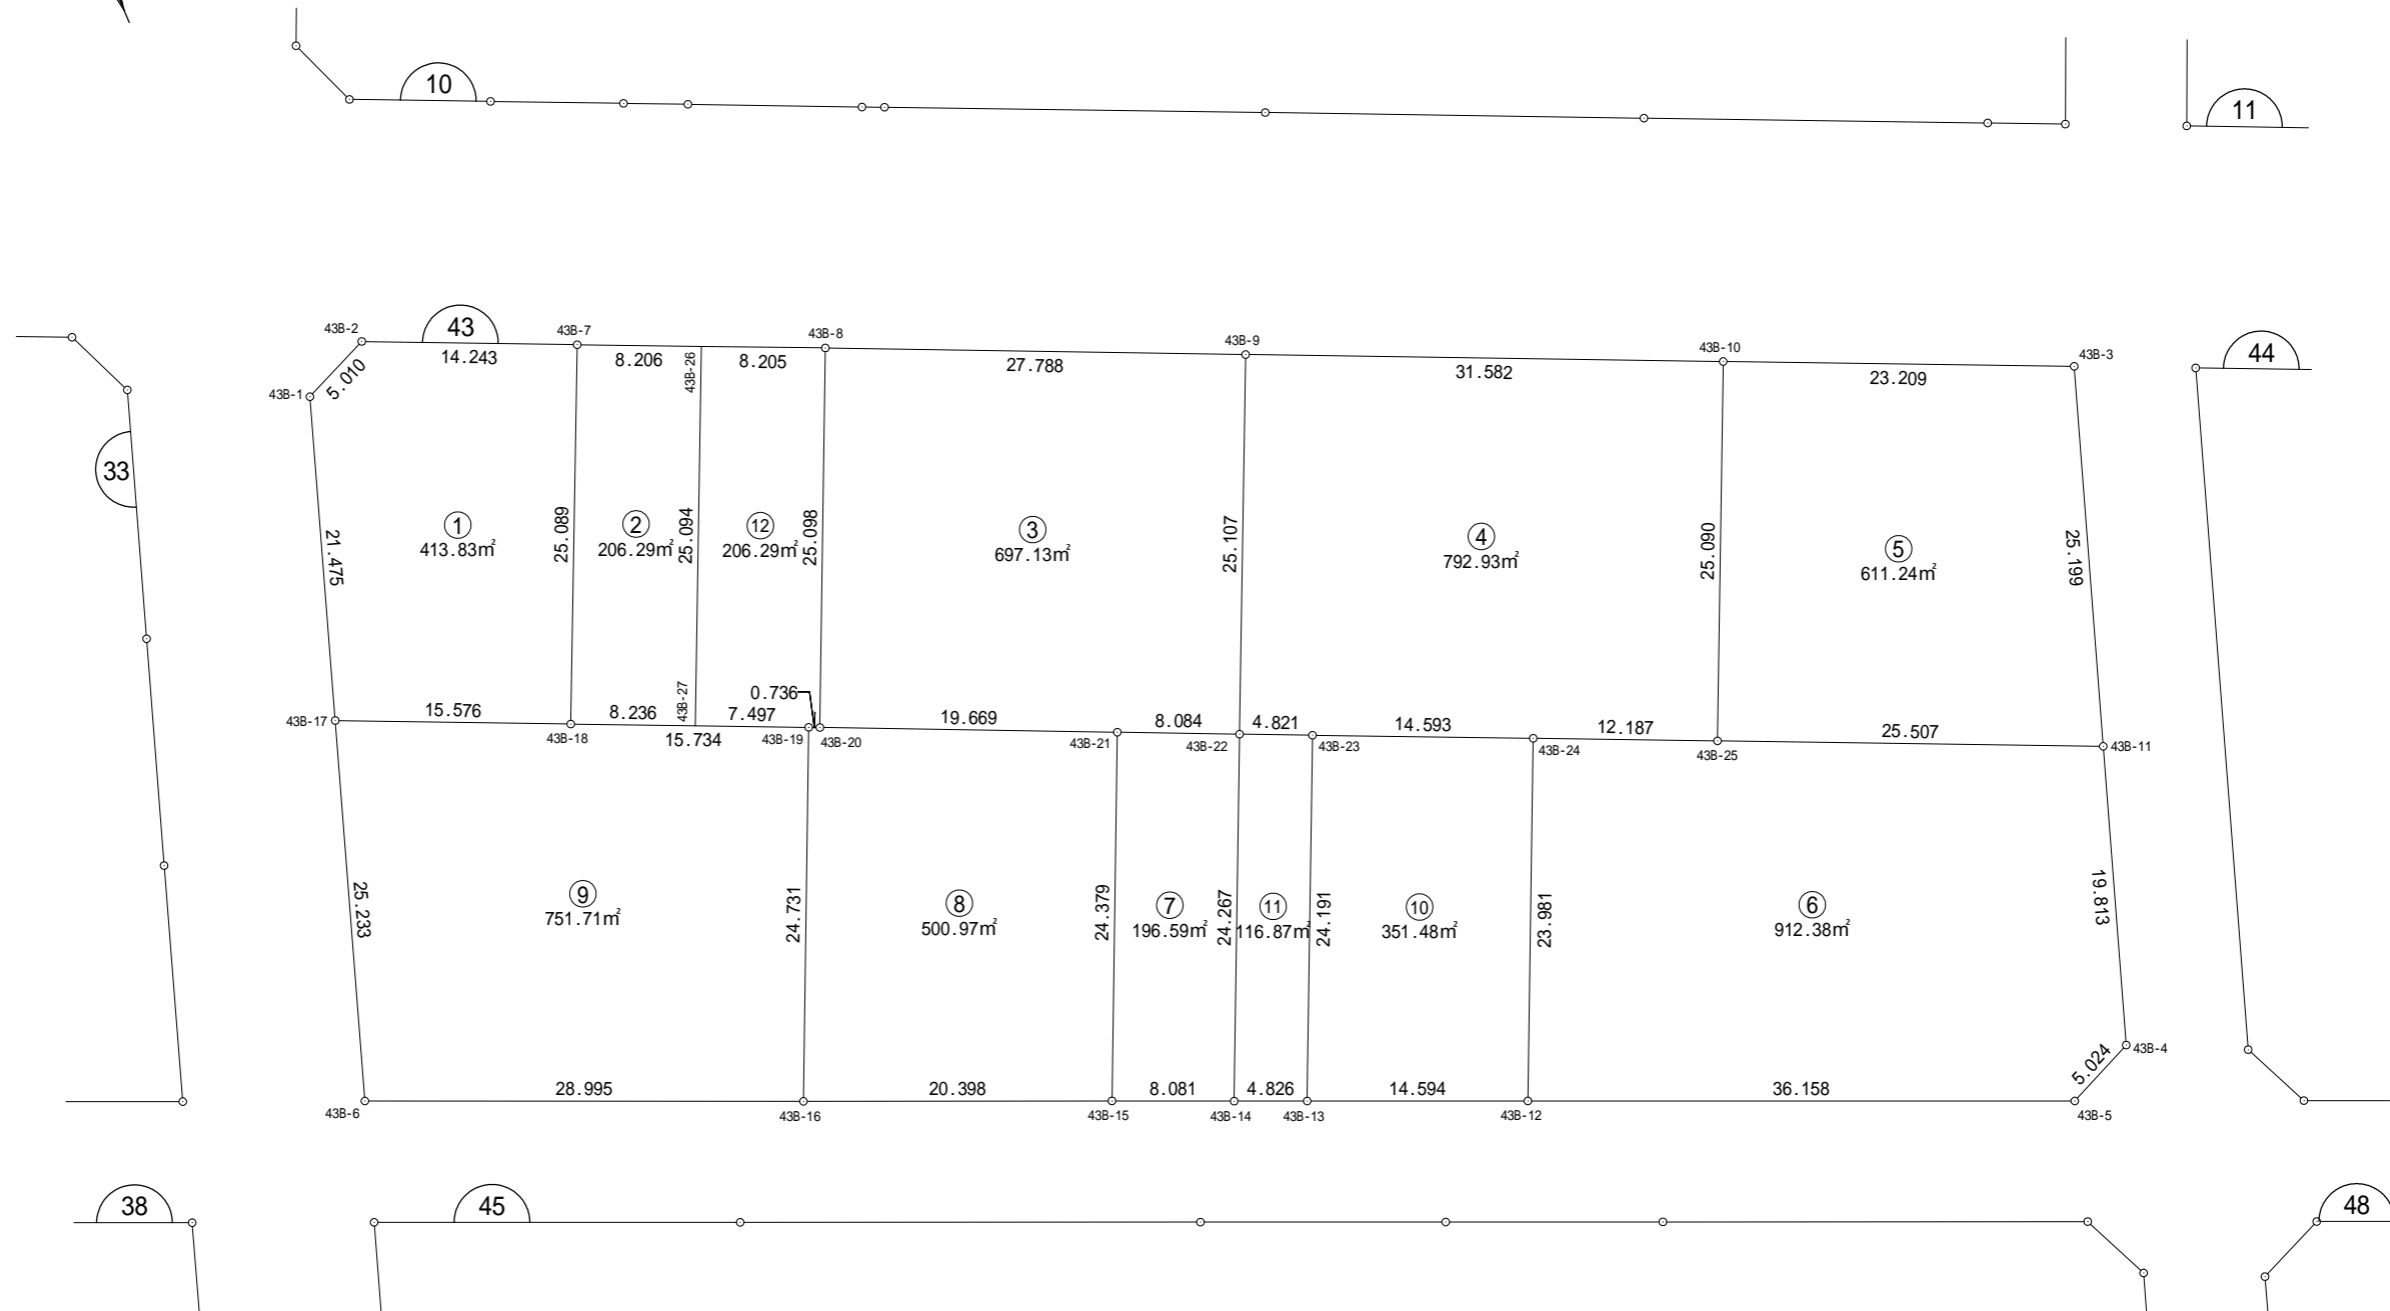

街区面積 6641.98  
 画地面積 6641.95  
 差 0.03

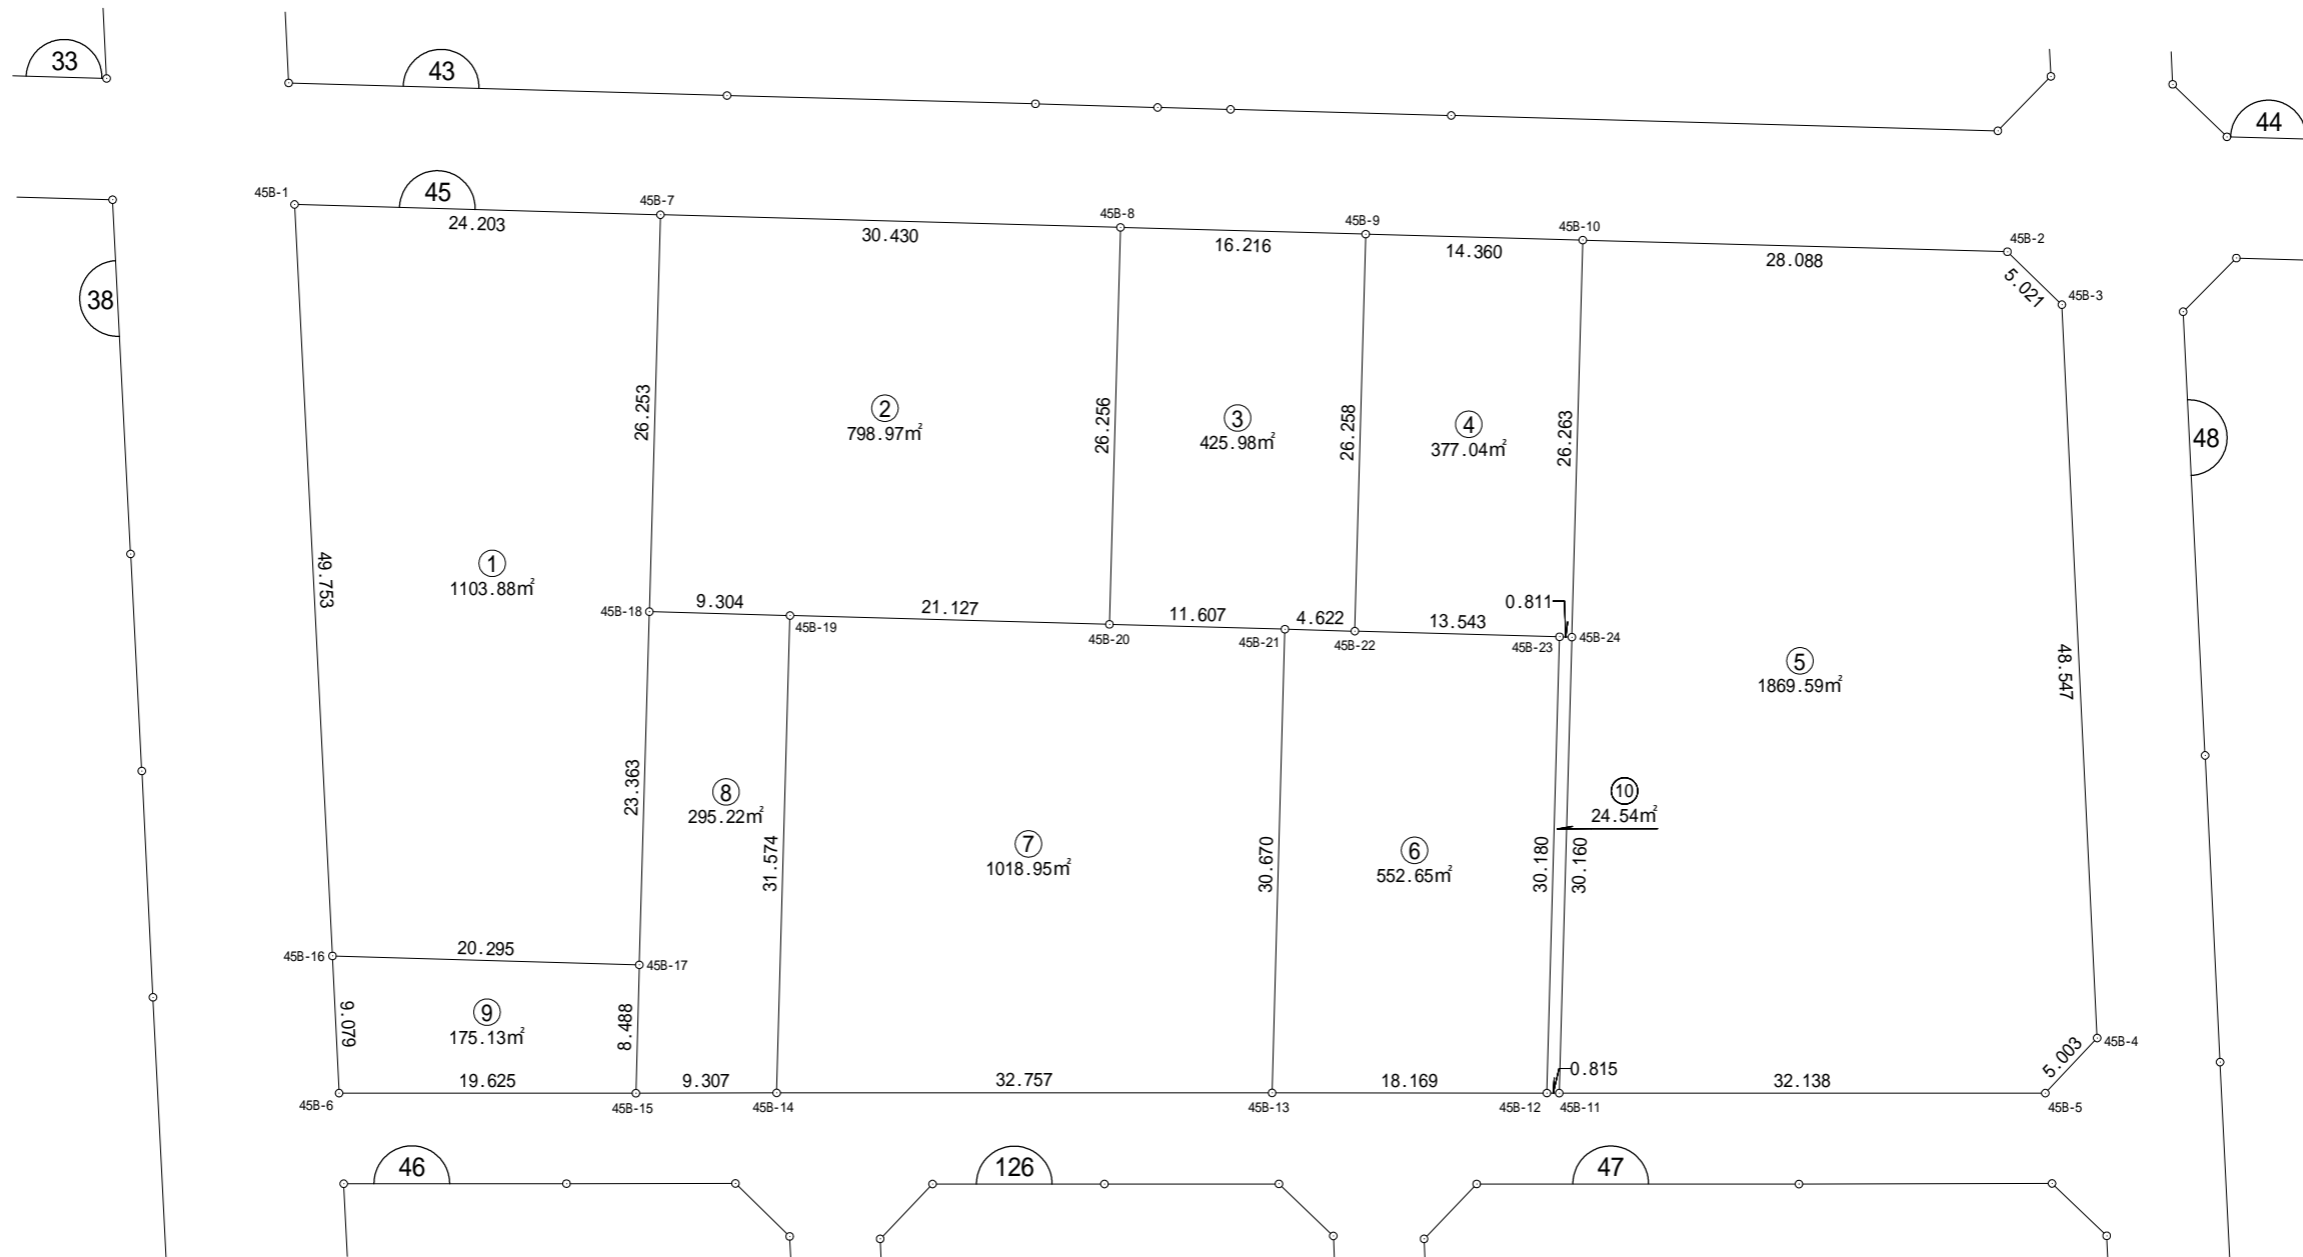




街区面積 4932.60

画地面積 4932.49


差 0.11

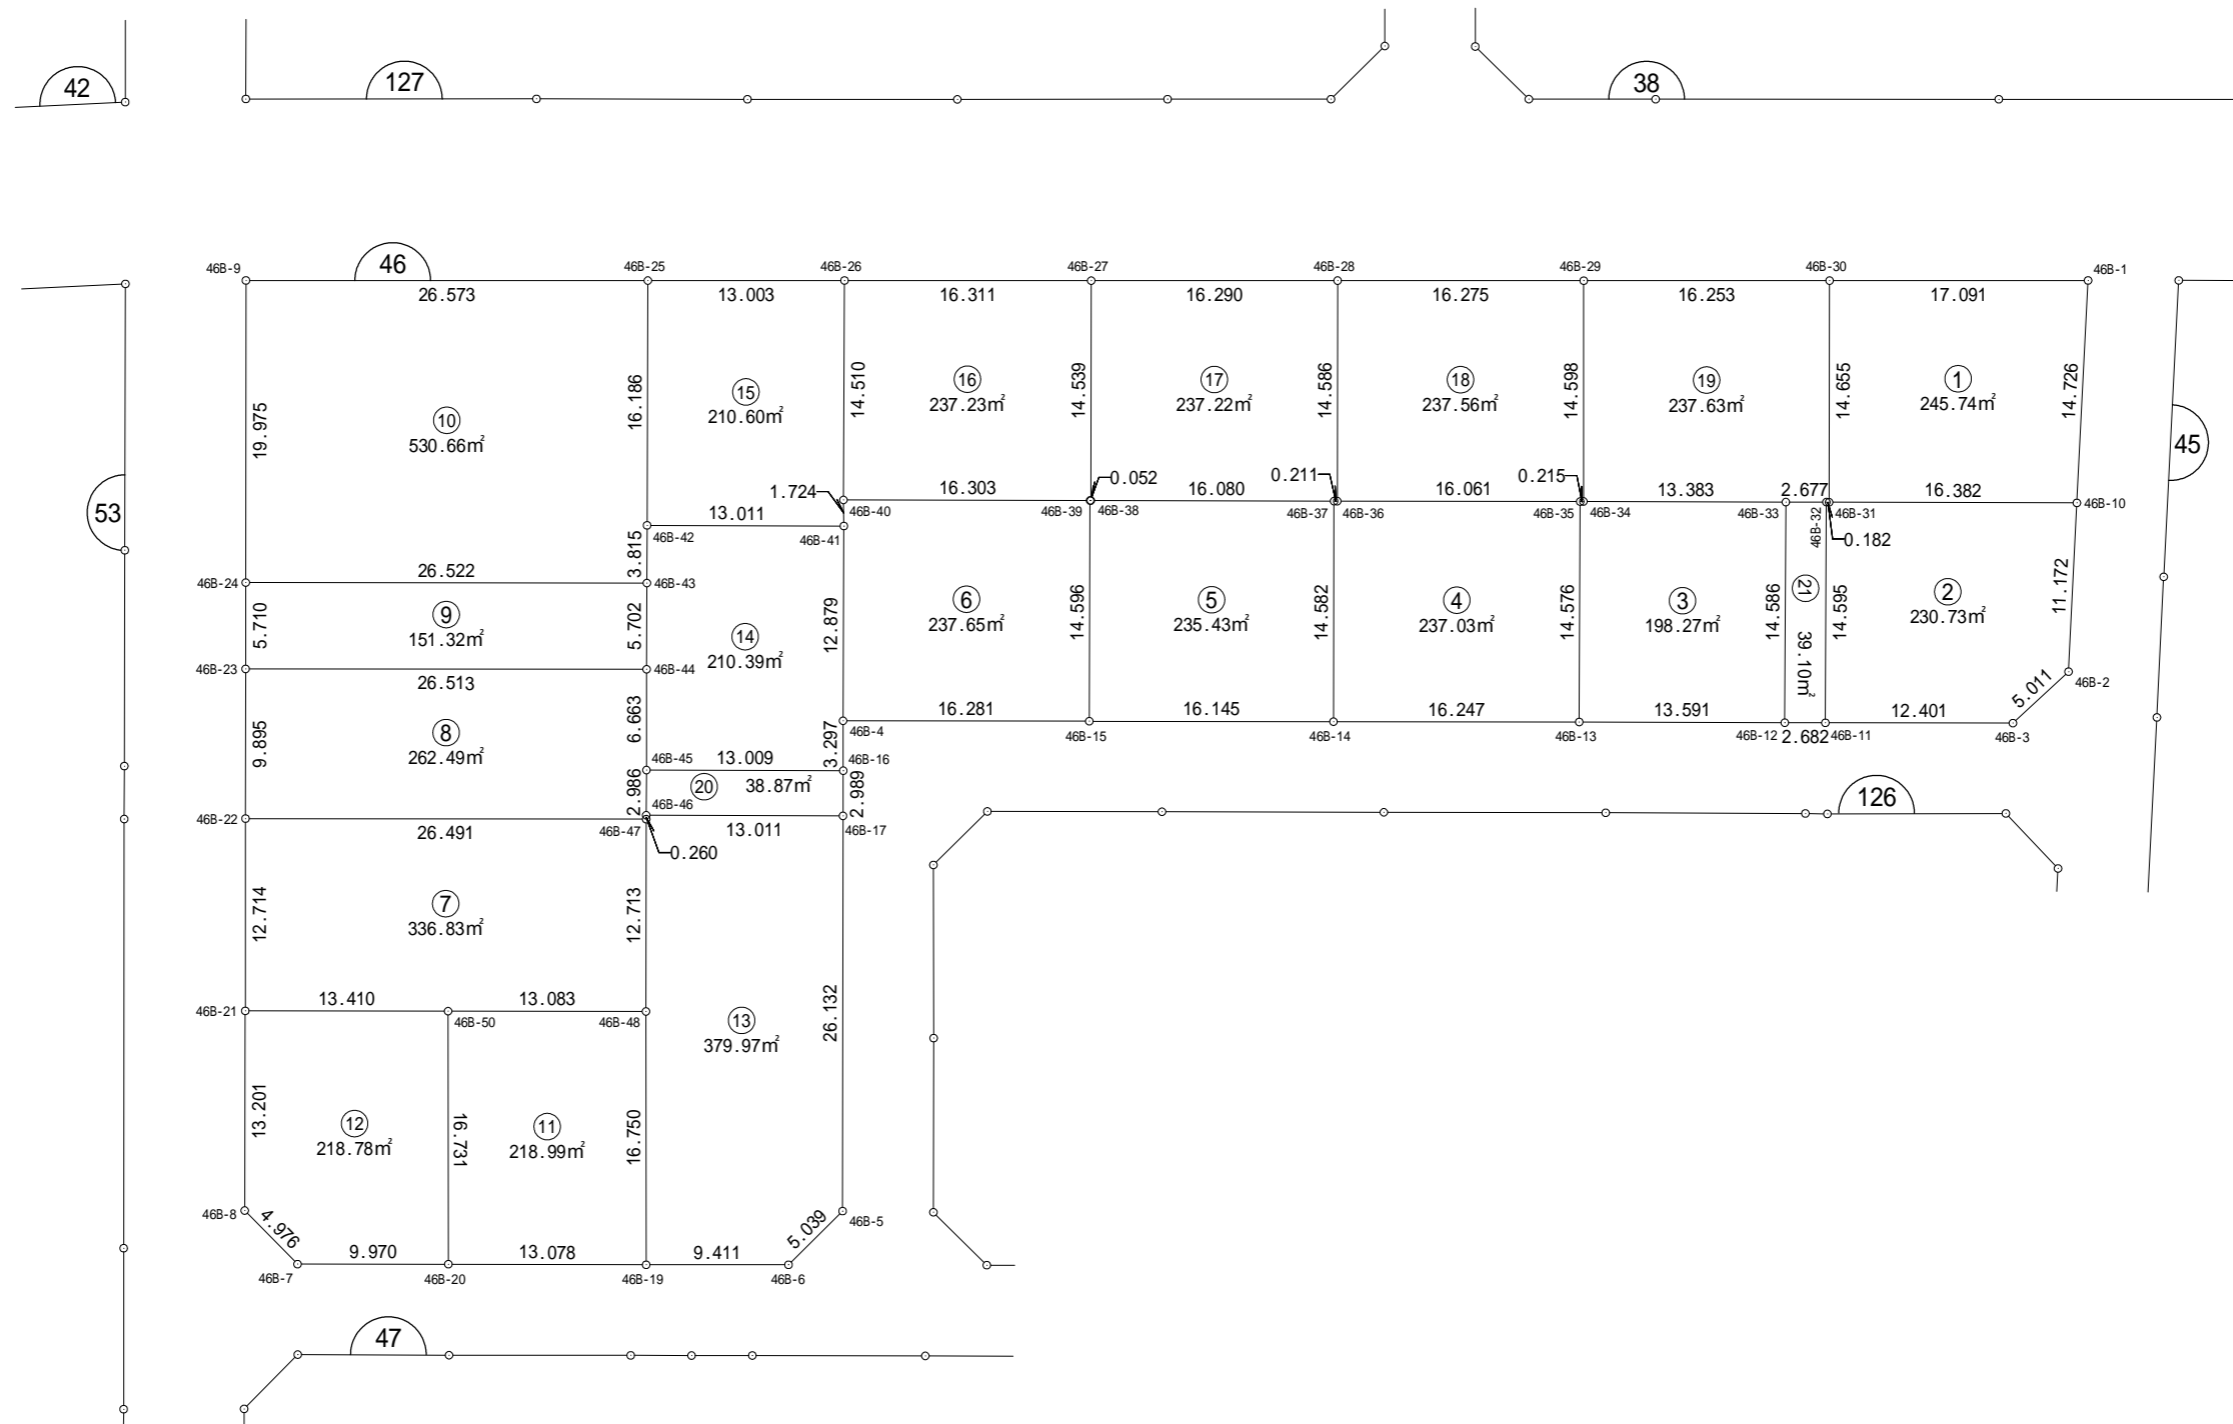

街区面積 5252.92


画地面積 5252.85

差 0.07

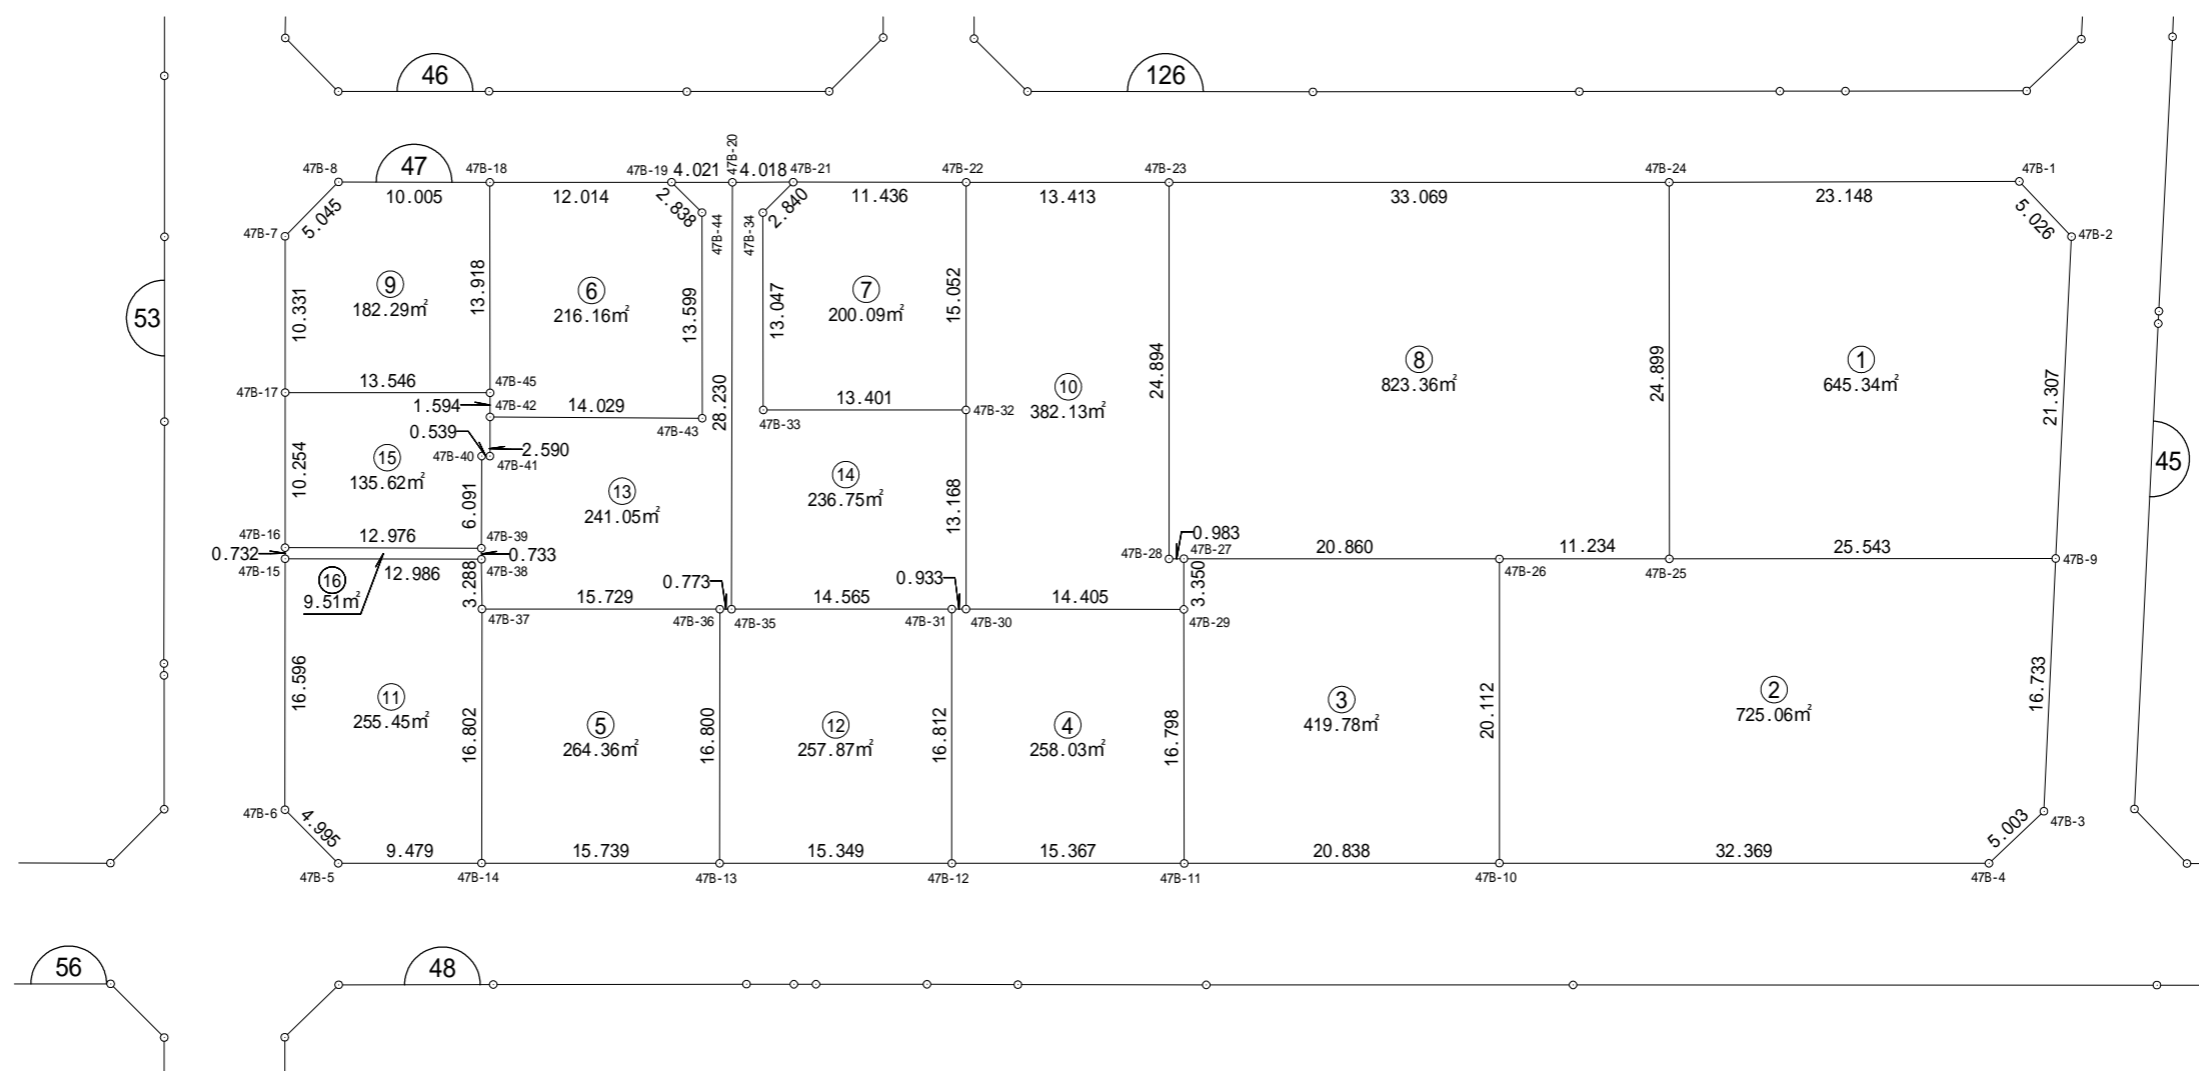




街区面積	5489.86
画地面積	5489.80
差	0.06

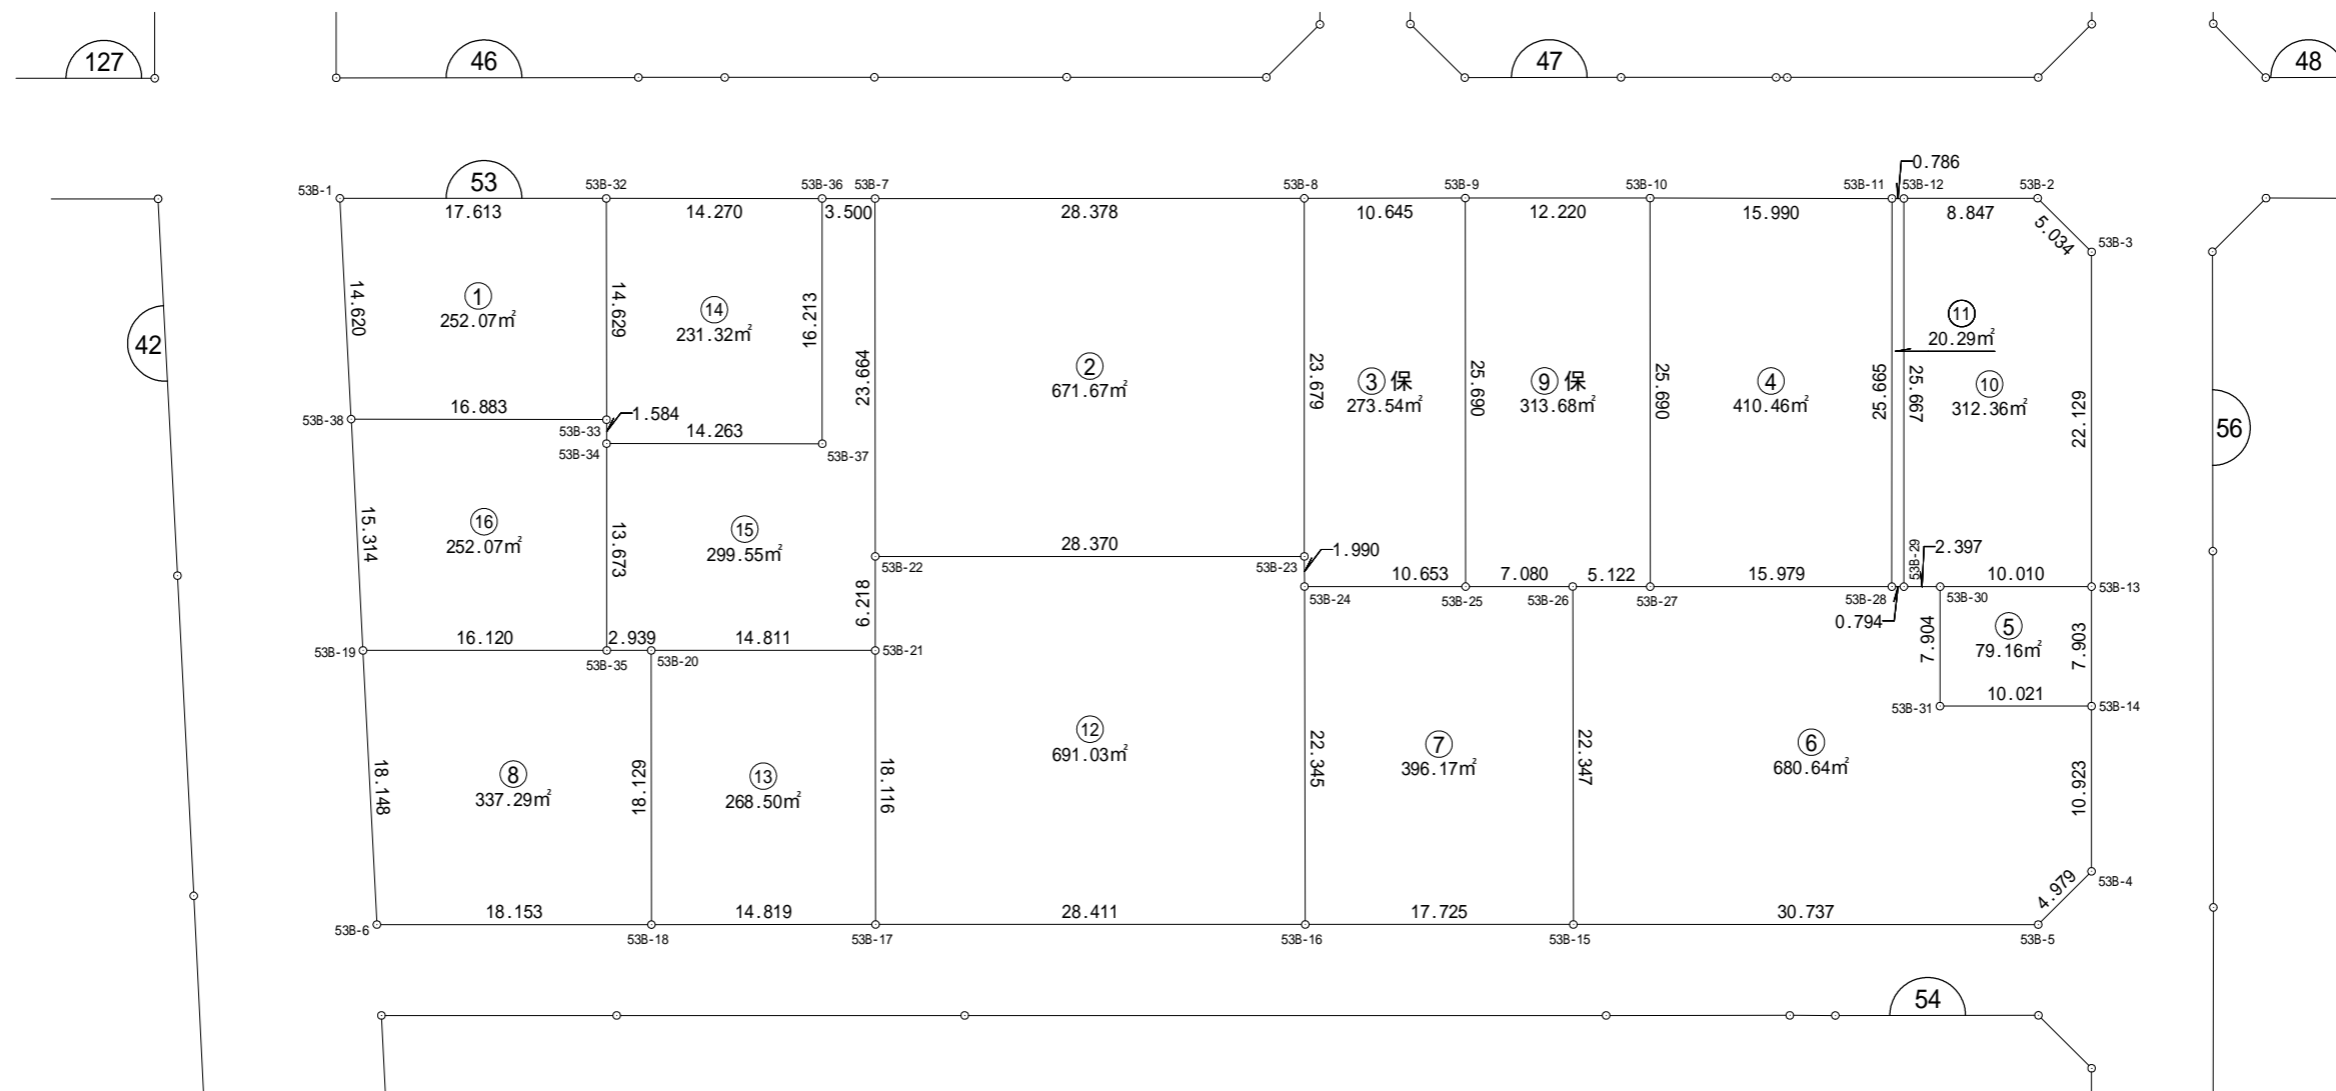



街区面積 4490.72  
 画地面積 4490.67  
 差 0.05

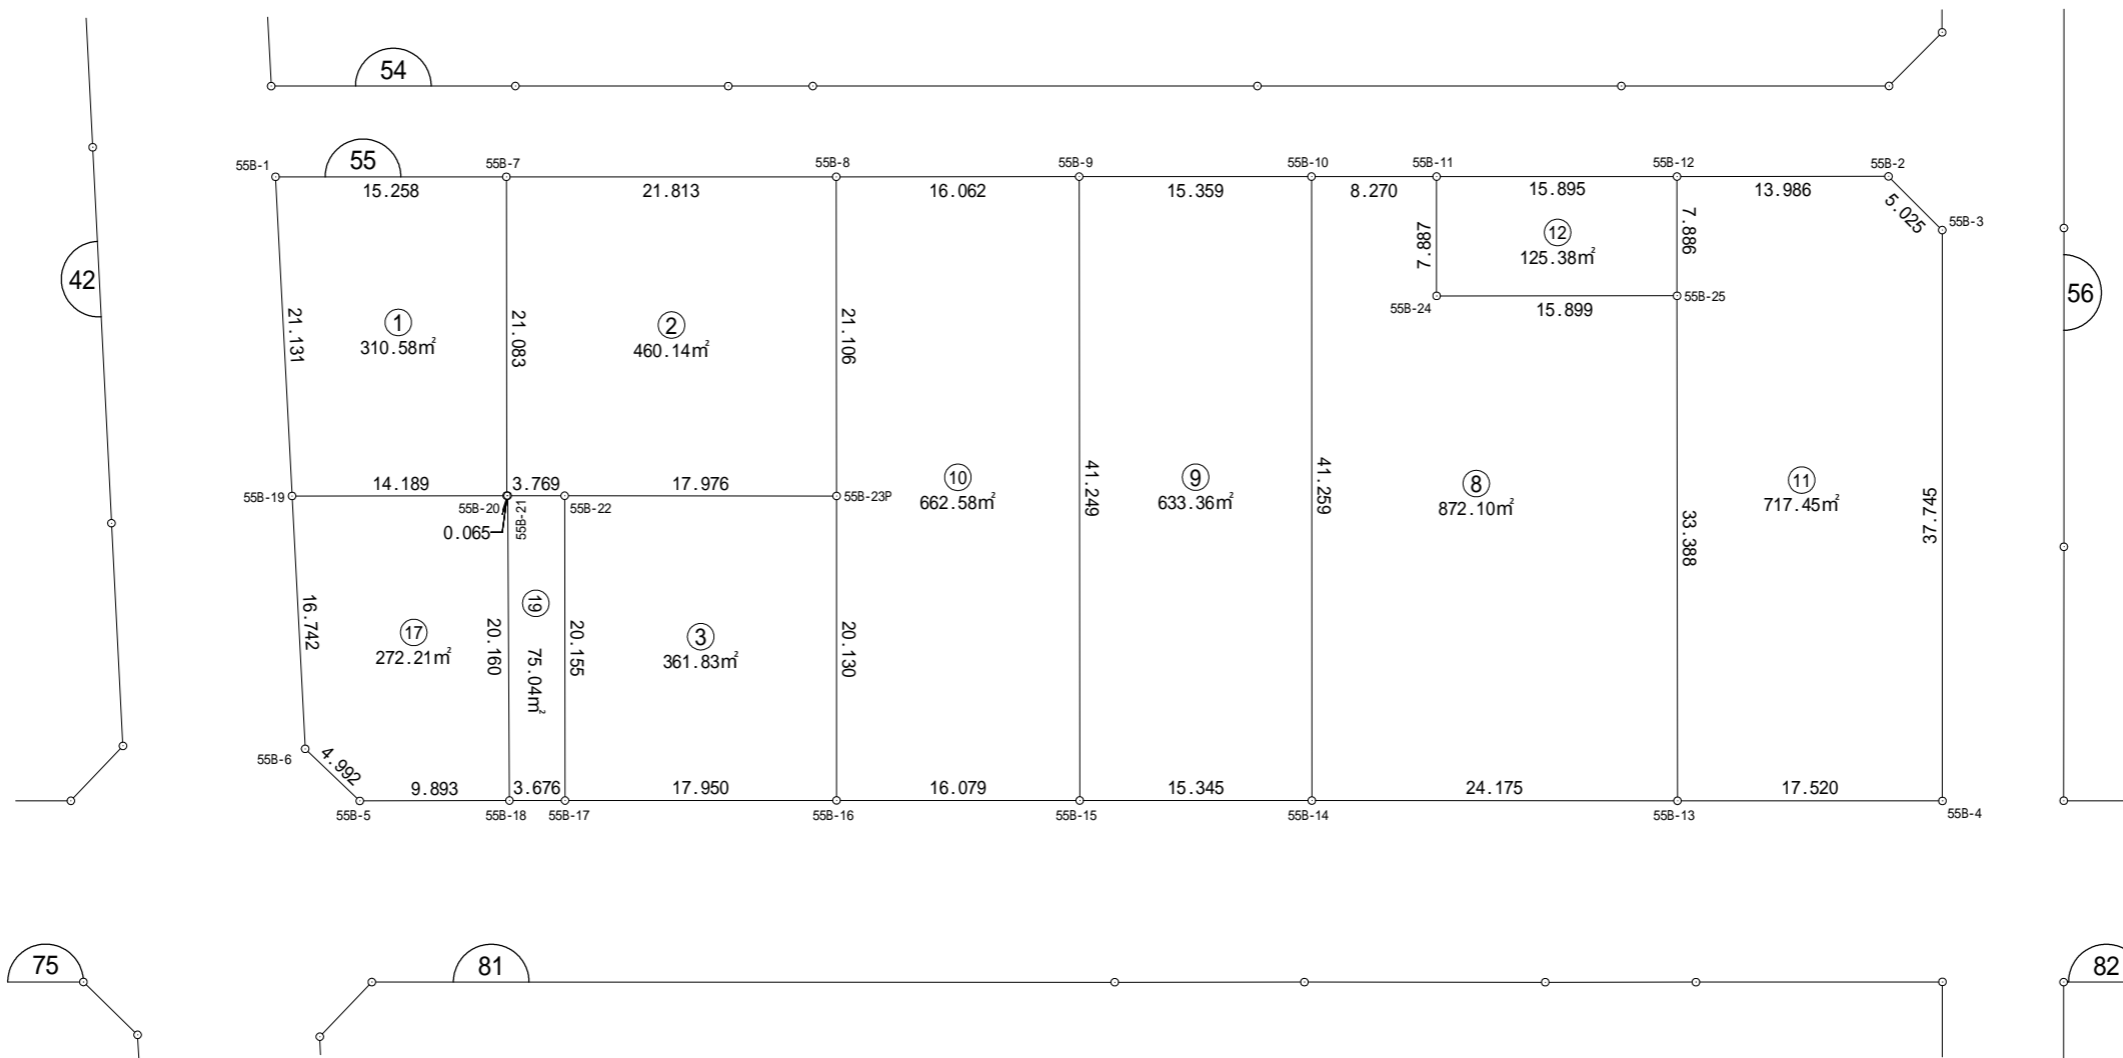



街区面積 2407.85

画地面積 2407.80

差 0.05

